


15-065-02290-0000

STATE OF KANSAS  
STATE CORPORATION COMMISSION

Give All Information Completely  
Make Required Affidavit  
Mail or Deliver Report to:  
Conservation Division  
State Corporation Commission  
800 Bitting Building  
Wichita, Kansas

WELL PLUGGING RECORD

NORTH

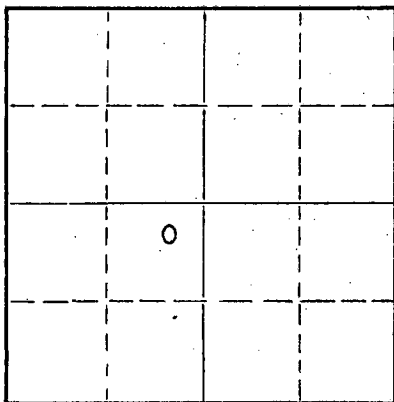

Locate well correctly on above  
Section Plat

Graham County, Sec. 8 Twp. 10S Rge. (E) 23 (W)  
Location as "NE/CNW/SW" or footage from lines NE NE SW  
Lease Owner Colorado Oil and Gas Corporation  
Lease Name Dietz "C" Well No. 1  
Office Address Box 1030 Wichita, Kansas  
Character of Well (completed as Oil, Gas or Dry Hole) Dry Hole  
Date well completed July 21, 1955 19  
Application for plugging filed July 21, 1955 19  
Application for plugging approved July 21, 1955 19  
Plugging commenced July 22, 1955 19  
Plugging completed July 22, 1955 19  
Reason for abandonment of well or producing formation Dry Hole

If a producing well is abandoned, date of last production \_\_\_\_\_ 19\_\_\_\_  
Was permission obtained from the Conservation Division or its agents before plugging was commenced? \_\_\_\_\_

Name of Conservation Agent who supervised plugging of this well \_\_\_\_\_  
Producing formation \_\_\_\_\_ Depth to top \_\_\_\_\_ Bottom \_\_\_\_\_ Total Depth of Well 3985 Feet  
Show depth and thickness of all water, oil and gas formations.

OIL, GAS OR WATER RECORDS

CASING RECORD

FORMATION	CONTENT	FROM	TO	SIZE	PUT IN	PULLED OUT
				8 5/8"	199	None

Describe in detail the manner in which the well was plugged, indicating where the mud fluid was placed and the method or methods used in introducing it into the hole. If cement or other plugs were used, state the character of same and depth placed, from \_\_\_\_\_ feet to \_\_\_\_\_ feet for each plug set.

Bottom plug set at 190' with 15 sacks cement and 1/2 sack hulls.  
Top plug set at 40' with 10 sacks cement and 1/2 sack hulls.

(If additional description is necessary, use BACK of this sheet)

Name of Plugging Contractor Graham-Messman-Rinehart Oil Company (License No. 20)  
Address 1005 East Second Wichita, Kansas


STATE OF KANSAS, COUNTY OF SEDGWICK, ss.  
BILL K. HENRICHS (employee of owner) or (~~owner or operator~~) of the above-described well, being first duly sworn on oath, says: That I have knowledge of the facts, statements, and matters herein contained and the log of the above-described well as filed and that the same are true and correct. So help me God.

(Signature) Bill K. Henrichs  
Box 1030 Wichita, Kansas  
(Address)

SUBSCRIBED AND SWORN to before me this 28th day of July, 19 55

My commission expires August 24, 1957

Notary Public.

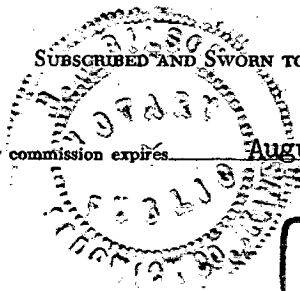

**PLUGGING**  
FILE SEC 8 T 10 R 23  
BOOK PAGE 137 LINE 14

RECEIVED  
STATE CORPORATION COMMISSION  
07-29-55  
CONSERVATION DIVISION  
Wichita, Kansas

NO. 1 DIETZ "C"WELL RECORD

Location: NE NE SW, 8-10S-23W  
Graham County, Kansas

Operator: Colorado Oil & Gas Corporation  
430 West Douglas, Wichita, Kansas

Contractor: Graham-Messman-Rinehart Oil Company  
1005 East Second, Wichita, Kansas

Casing Record: 8 5/8" @ 199' w/150 sacks cement

Commenced: 7-14-55  
Completed: 7-22-55  
Elevation: 2415 KB  
Production: D&A

## .....L O G.....

Surface hole	200
Shale	1300
Shale-Sand	1540
Sand	1760
Red Bed-Shale	2000
Shale	2010
Anhydrite	2051
Salt-Shale	2260
Shale	2565
Shale-Lime	2735
Lime-Shale	2905
Shale-Lime	3140
Lime-Shale	3410
Shale-Lime	3540
Shale-Lime	3660
Lime-Shale	3865
Lime	3985 R.T.D.

Sample Tops:

Anhydrite 2010 (+505)  
Lansing 3754 (-1339)

The undersigned, GRAHAM-MESSMAN-OIL COMPANY, hereby certifies that the above log is a true and correct log of the formation encountered in drilling the above well as reflected by the Daily Drilling Report.

GRAHAM-MESSMAN-RINEHART OIL COMPANY

By:

*Roger L. Messman*  
Roger L. Messman

Subscribed and sworn to before me  
this 25th day of July, 1955.

*Juanita L. Lewis*  
Notary Public

My Commission Expires: November 5, 1958

