


WELL PLUGGING RECORD

Give All Information Completely  
Make Required Affidavit  
Mail or Deliver Report to:  
Conservation Division  
State Corporation Commission  
212 North Market, Insurance Bldg.  
Wichita, Kansas

NORTH

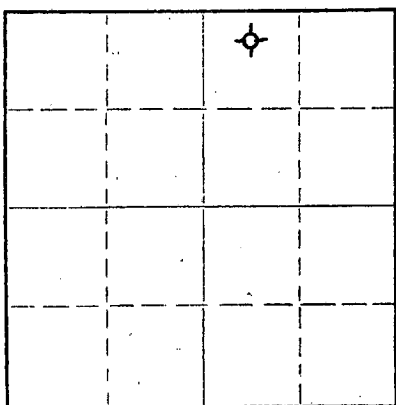

Locate well correctly on above  
Section Plat

Graham County, Sec. 8 Twp. 10 Rge. 23 (E) W (W)  
Location as "NE/CNW/SW" or footage from lines C N Line NW NE  
Lease Owner C-G Drilling Co. & Houston Petroleum Co.  
Lease Name Law Well No. 2  
Office Address 107 Rule Building, Wichita 2, Kansas  
Character of Well (completed as Oil, Gas or Dry Hole) D & A  
Date well completed September 18 19 61  
Application for plugging filed September 18 19 61  
Application for plugging approved September 18 19 61  
Plugging commenced September 18 19 61  
Plugging completed September 18 19 61  
Reason for abandonment of well or producing formation Too low structurally

If a producing well is abandoned, date of last production \_\_\_\_\_ 19\_\_\_\_  
Was permission obtained from the Conservation Division or its agents before plugging was commenced? Yes

Name of Conservation Agent who supervised plugging of this well Eldon Petty, Hays, Kansas  
Producing formation \_\_\_\_\_ Depth to top \_\_\_\_\_ Bottom \_\_\_\_\_ Total Depth of Well 3990 Feet  
Show depth and thickness of all water, oil and gas formations.

OIL, GAS OR WATER RECORDS

CASING RECORD

FORMATION	CONTENT	FROM	TO	SIZE	PUT IN	PULLED OUT
				8-5/8"	225.63'	None

Describe in detail the manner in which the well was plugged, indicating where the mud fluid was placed and the method or methods used in introducing it into the hole. If cement or other plugs were used, state the character of same and depth placed, from \_\_\_\_\_ feet to \_\_\_\_\_ feet for each plug set.

Filled hole with heavy mud to 550'. Set plug. Put in 20 sacks cement. Filled to 180'. Set plug. Put in 20 sacks cement. Filled with heavy mud up to 40'. Set plug. Filled to top with 1 sack hulls and 10 sacks cement.

RECEIVED  
STATE CORPORATION COMMISSION

SEP 26 1961


CONSERVATION DIVISION  
Wichita, Kansas

(If additional description is necessary, use BACK of this sheet)

Name of Plugging Contractor C-G Drilling Co.  
Address 107 Rule Building, Wichita 2, Kansas

STATE OF KANSAS, COUNTY OF SEDGWICK, ss.  
G. F. Galloway (employee of owner) or (owner or operator) of the above-described well, being first duly sworn on oath, says: That I have knowledge of the facts, statements, and matters herein contained and the log of the above-described well as filed and that the same are true and correct. So help me God.  
(Signature) G. F. Galloway  
(Address) 107 Rule Building

SUBSCRIBED AND SWORN TO before me this 22nd day of September, 1961  
Vicky Jacobs  
Vicky Jacobs - Notary Public.

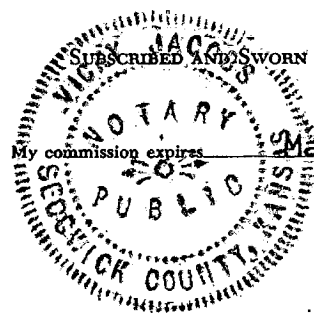

W E L L L O G

OPERATOR C-G Drilling Co. & Houston Petroleum Co. SEC. 8-10-23  
 WELL NAME Law #2 LOC. C N Line NW NE  
 TOTAL DEPTH 3990' COUNTY Graham  
 COMM. September 9, 1961 COMP. September 18, 1961 STATE Kansas  
 RIG NO. 2 ELEVATION 2417' R.B.  
 CASING: Ran 225.63' (11 jts.) 8-5/8" OD Surface Casing. PRODUCTION: D & A

All measurements taken from the top of rotary bushing.

FROM	TO	FORMATION	DEVIATION FROM VERTICAL	REMARKS:
0	223	Shale & Sand		
223	1550	Shale		
1550	1740	Sand		
1740	2010	Red Bed		
2010	2040	Anhydrite		
2040	2495	Shale & Shells	00 - 2500	
2495	3558	Shale & Lime	00 - 2750	
3558	3635	Lime & Shale	00 - 3000	
3635	3990	Lime	00 - 3250	DST 3721-3746'
			00 - 3500	DST 3898-3914'
			00 - 3750	DST 3910-3955'

RECEIVED  
STATE CORPORATION COMMISSION

SEP 26 1961

CONSERVATION DIVISION  
Wichita, Kansas

STATE OF KANSAS )  
 ) SS.  
 COUNTY OF SEDGWICK )

The undersigned hereby certifies that to the best of his knowledge and belief, the above facts are true and correct.

C-G DRILLING CO.

By G. F. Galloway  
G. F. Galloway

THIS 22nd day of September, 1961.

Vicky Jacobs  
Vicky Jacobs - Notary Public

