

STATE OF KANSAS  
STATE CORPORATION COMMISSION  
Give All Information Completely  
Make Required Affidavit  
Mail or Deliver Report to:  
Conservation Division  
State Corporation Commission  
211 No. Broadway  
Wichita, Kansas

WELL PLUGGING RECORD

Graham County. Sec. 8 Twp. 10 Rge. 23 (E) (W)

Location as "NE/CNW/SW" or footage from lines. SW SW NE

Lease Owner C-G Drilling Co.

Lease Name Law Well No. 3

Office Address 107 Rule Building, Wichita 2, Kansas

Character of Well (completed as Oil, Gas or Dry Hole) Dry Hole

Date well completed November 4 1962

Application for plugging filed November 4 1962

Application for plugging approved November 4 1962

Plugging commenced November 4 1962

Plugging completed November 4 1962

Reason for abandonment of well or producing formation Too low structurally


If a producing well is abandoned, date of last production \_\_\_\_\_ 19\_\_\_\_

Was permission obtained from the Conservation Division or its agents before plugging was commenced? Yes

Name of Conservation Agent who supervised plugging of this well Eldon Petty, Hays, Kansas

Producing formation \_\_\_\_\_ Depth to top \_\_\_\_\_ Bottom \_\_\_\_\_ Total Depth of Well 3937 Feet

Show depth and thickness of all water, oil and gas formations.

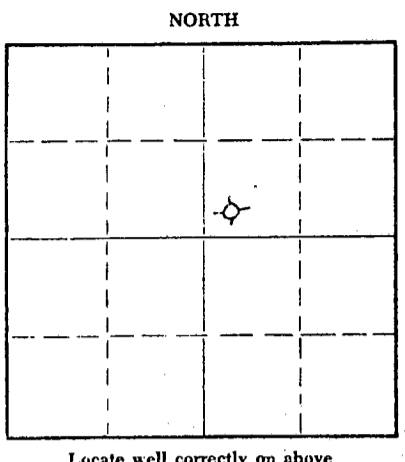

Locate well correctly on above Section Plat

OIL, GAS OR WATER RECORDS

CASING RECORD

FORMATION	CONTENT	FROM	TO	SIZE	PUT IN	PULLED OUT
				8-5/8"	198.24	None

Describe in detail the manner in which the well was plugged, indicating where the mud fluid was placed and the method or methods used in introducing it into the hole. If cement or other plugs were used, state the character of same and depth placed, from \_\_\_\_\_ feet to \_\_\_\_\_ feet for each plug set.


Filled hole with heavy mud to 500'. Set plug. Put in 20 sacks cement. Filled with heavy mud to 190'. Set plug. Put in 20 sacks of cement. Filled with heavy mud up to 40'. Set plug. Filled to top with 1 sack hulls and 10 sacks cement.

RECEIVED  
STATE CORPORATION COMMISSION  
NOV 14 1962  
11-14-62  
CONSERVATION DIVISION  
Wichita, Kansas

(If additional description is necessary, use BACK of this sheet)  
Name of Plugging Contractor C-G Drilling Co.  
Address 107 Rule Building, Wichita 2, Kansas

STATE OF KANSAS, COUNTY OF SEDGWICK, ss.  
G. F. Galloway (employee of owner) or (owner or operator) of the above-described well, being first duly sworn on oath, says: That I have knowledge of the facts, statements, and matters herein contained and the log of the above-described well as filed and that the same are true and correct. So help me God.  
(Signature) G. F. Galloway  
107 Rule Building  
(Address)

Subscribed and sworn to before me this 8 day of November, 1962  
Vicky Jacobs  
Vicky Jacobs Notary Public.

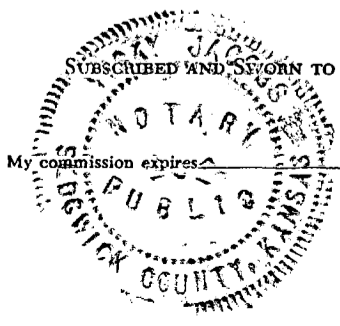

W E L L L O G

OPERATOR C-G Drilling Co. SEC. 8-10-23  
 WELL NAME Law #3 LOC. SW SW NE  
 TOTAL DEPTH 3937 COUNTY Graham  
 COMM. 10/26/62 COMP. 11/5/62 STATE Kansas  
 RIG NO. 1 ELEVATION 2381 K.B.  
 CASING: Set 198.24' (10 jts.) 8-5/8" OD Surface Casing. PRODUCTION: D & A

All measurements taken from the top of rotary bushing.

FROM	TO	FORMATION	DEVIATION FROM VERTICAL	REMARKS:
0	340	Shale		
340	1490	Shale-Sand	500' - 1/2°	
1490	1715	Sand	1050' - 3/4°	
1715	1973	Red Bed	1500' - 1/2°	
1973	2015	Anhydrite	2000' - 1/2°	
2015	2085	Shells-Shale		
2085	2475	Shale-Shells		
2475	2525	Shells-Shale	2500' - 3/4°	
2525	3385	Shale-Lime	3000' - 3/4°	
3385	3540	Lime-Shale		
3540	3625	Shale-Lime		
3625	3702	Lime-Shale		DST #1 3677-3702
3702	3760	Lime		DST #2 3739-3760
3760	3810	Lime-Shale		DST #3 3860-3895
3810	3875	Lime		DST #4 3871-3896
3875	3896	Lime		DST #5 3898-3912
3896	3915	Lime		
3915	3937	Lime-Shale		

**RECEIVED**  
 STATE CORPORATION COMMISSION

NOV 11 1962

CONSERVATION DIVISION  
 Wichita, Kansas

STATE OF KANSAS )  
 ) SS.  
 COUNTY OF SEDGWICK )

The undersigned hereby certifies that to the best of his knowledge and belief, the above facts are true and correct.

C-G DRILLING CO.

By G. F. Galloway  
 G. F. Galloway  
 THIS 8 day of November, 1962.

Vicky Jacobs  
 Vicky Jacobs - Notary Public

