

15-065-00421-0000


STATE OF KANSAS
STATE CORPORATION COMMISSION

WELL PLUGGING RECORD

Give All Information Completely
Make Required Affidavit
Mail or Deliver Report to:
Conservation Division
State Corporation Commission
800 Biting Building
Wichita, Kansas

Graham County, Sec. 8 Twp. 10S Rge. (E) 23 (W)

Location as "NE/CNW&SW" or footage from lines. SW SW NW
Lease Owner Mid-Continent Petroleum Corporation
Lease Name John Dietz Well No. 1
Office Address 512 Orpheum Bldg., Wichita, Kansas
Character of Well (completed as Oil, Gas or Dry Hole) Dry Hole
Date well completed August 8 19 54
Application for plugging filed August 8 19 54
Application for plugging approved August 9 19 54
Plugging commenced August 20 19 54
Plugging completed August 24 19 54
Reason for abandonment of well or producing formation Dry Hole

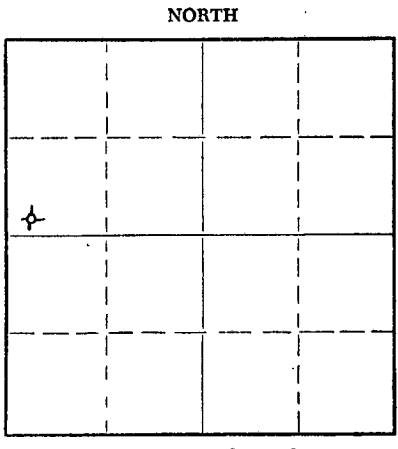

Locate well correctly on above Section Plat

If a producing well is abandoned, date of last production 19
Was permission obtained from the Conservation Division or its agents before plugging was commenced? Yes

Name of Conservation Agent who supervised plugging of this well Warren H. Horner
Producing formation Depth to top Bottom Total Depth of Well 4325 Feet
Show depth and thickness of all water, oil and gas formations.

OIL, GAS OR WATER RECORDS

CASING RECORD

FORMATION	CONTENT	FROM	TO	SIZE	PUT IN	PULLED OUT
Topeka lime	Dry	3470		10 3/4"	208'	None
Heebner shale	Dry	3691		7" OD	4014'	2722'
Toronto lime	Dry	3715				
Lansing lime	Show oil	3728	3956			
Marmaton chert	Dry	4048				
Mississippi dolomite	Dry	4256				
Mississippi chert	Dry	4266				
Arbuckle dolomite	Water	4306				

Describe in detail the manner in which the well was plugged, indicating where the mud fluid was placed and the method or methods used in introducing it into the hole. If cement or other plugs were used, state the character of same and depth placed, from feet to feet for each plug set.

Pipe filled with chat from 3898 to 3870, 5 sax of cement from 3820 to 3846, hole filled with heavy mud from 3846 to 215, rock bridge at 215, 25 sax of cement from 215 to 165, hole filled with heavy mud from 165 to 30, rock bridge at 30', 15 sax of cement from 30' to top of surface pipe.

RECEIVED
STATE CORPORATION COMMISSION

AUG 31 1954 08-31-54

CONSERVATION DIVISION
Wichita, Kansas


(If additional description is necessary, use BACK of this sheet)

Name of Plugging Contractor Morgan Well Plugging Service
Address 410 South Douglas, Lyons, Kansas

STATE OF Kansas, COUNTY OF Sedgwick, ss.
R. L. Mankey (employee of owner) or (owner or operator) of the above-described well, being first duly sworn on oath, says: That I have knowledge of the facts, statements, and matters herein contained and the log of the above-described well as filed and that the same are true and correct. So help me God.

(Signature) R. L. Mankey
512 Orpheum Bldg., Wichita, Kansas (Address)

SUBSCRIBED AND SWORN to before me this 30 day of August, 1954
My commission expires Mar. 28, 1957
Mae Resco Notary Public.

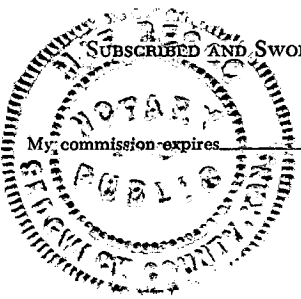

PLUGGING
FILE SEC 8 T 10 R 23W
BOOK PAGE 52 LINE 35

JOHN DIETZ WELL NO. 1
SW SW NW Section 8-10S-23W
Graham County, Kansas
MID-CONTINENT PETROLEUM CORPORATION

CASING RECORD:

Set 10 3/4" @ 215' w/ 150 sax
Set 7" @ 3989' w/ 200 sax

COMMENCED: 7-3-54
COMPLETED: 7-21-54
RESULT: D & A

Surface sand & clay	0	50
Shale & shells	50	140
Shale & shells	140	1250
Sand	1250	1315
Shale	1315	1675
Sandy shale & red rock	1675	1739
Shale & shells	1739	2000
Anhydrite	2000	2035
Shale & shells	2035	2085
Shale	2085	2255
Shale & shells	2255	2450
Shale	2450	2550
Lime	2550	2630
Lime & shale	2630	2875
Shale & shells	2875	3005
Lime & shale	3005	3485
Lime	3485	3713
Lime	3713	4122
Shale & lime	4122	4180
Lime	4180	4205
Lime, chert & shale	4205	4275
Lime, chert & shale	4275	4348
TOTAL DEPTH	4348	

STATE OF Kansas
COUNTY OF Sedgwick

I hereby affirm that the above and foregoing is a true and correct copy of the log of the John Dietz Well No. 1, located in the SW SW NW of section 8, township 10 South, range 23 West, Graham County, Kansas.

MID-CONTINENT PETROLEUM CORPORATION

R. L. Mowbray
District Production Superintendent

Subscribed and sworn to before me a Notary Public this 30th day of August, 1954.

Mae Resco
Notary Public

my Commission expires Mar. 28, 1957



PLUGGING
FILE SEC 8 T 10 R 23W
BOOK PAGE 52 LINE 35