


15-065-02289-0000

STATE OF KANSAS
STATE CORPORATION COMMISSION

Give All Information Completely
Make Required Affidavit
Mail or Deliver Report to:
Conservation Division
State Corporation Commission
800 Biting Building
Wichita, Kansas

WELL PLUGGING RECORD

NORTH

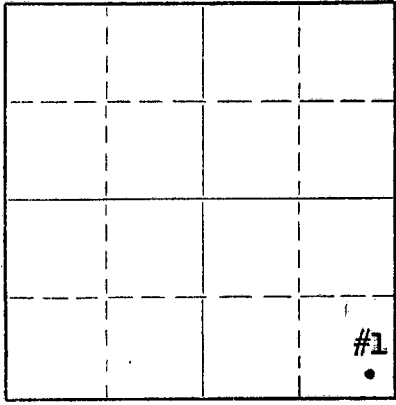

Locate well correctly on above
Section Plat

Graham County, Sec. 8 Twp. 10S Rge. 23W (E) (W)
Location as "NE/CNW/SWK" or footage from lines SE/4, SE/4, SE/4
Lease Owner Amerada Petroleum Corporation
Lease Name Irma Law "A" Well No. 1
Office Address Box 197 - Great Bend, Kansas
Character of Well (completed as Oil, Gas or Dry Hole) Dry Hole.
Date well completed July 29, 19 55
Application for plugging filed July 30, 19 55
Application for plugging approved July 30, 19 55
Plugging commenced July 30, 19 55
Plugging completed July 30, 19 55
Reason for abandonment of well or producing formation Dry Hole.

If a producing well is abandoned, date of last production 19
Was permission obtained from the Conservation Division or its agents before plugging was commenced? Yes

Name of Conservation Agent who supervised plugging of this well Mr. Eldon Petty of Hays, Kansas
Producing formation Depth to top Bottom Total Depth of Well 3940' Feet
Show depth and thickness of all water, oil and gas formations.

OIL, GAS OR WATER RECORDS

CASING RECORD

FORMATION	CONTENT	FROM	TO	SIZE	PUT IN	PULLED OUT
				8-5/8"	245'	None.

Describe in detail the manner in which the well was plugged, indicating where the mud fluid was placed and the method or methods used in introducing it into the hole. If cement or other plugs were used, state the character of same and depth placed, from feet to feet for each plug set.

Filled hole with heavy mud to 240' from top, set bridge plug & 1/2 sack hulls @ 240', spotted 15 sacks cement thru drill pipe, filled hole with heavy mud to 40' from top, set bridge plug & 1/2 sack hulls at 40', mixed & dumped in 10 sacks cement filling surface casing to top. Well plugged & abandoned 7-30-55 as required by State Plugger Mr. Eldon Petty of Hays, Kans.

RECEIVED
STATE CORPORATION COMMISSION

CONSERVATION DIVISION
WICHITA, KANSAS
08-03-55

(If additional description is necessary, use BACK of this sheet)
Name of Plugging Contractor Barbour Drilling Co.
Address Tulsa, Okla.

STATE OF Kansas, COUNTY OF Barton, ss.
B. A. Drake (employee of owner) or (owner or operator) of the above-described well, being first duly sworn on oath, says: That I have knowledge of the facts, statements, and matters herein contained and the log of the above-described well as filed and that the same are true and correct. So help me God.

(Signature) B. A. Drake
Box 197 - Great Bend, Kansas (Address)

SUBSCRIBED AND SWORN TO before me this 2nd day of August, 1955
Chas E. Johnson Notary Public.

My commission expires June 24, 1959

PLUGGING
FILE SEC 8 T 10 R 23W
BOOK PAGE 139 LINE 23