


STATE OF KANSAS  
STATE CORPORATION COMMISSION  
Give All Information Completely  
Make Required Affidavit  
Mail or Deliver Report to:  
Conservation Division  
State Corporation Commission  
211 No. Broadway  
Wichita, Kansas

### WELL PLUGGING RECORD

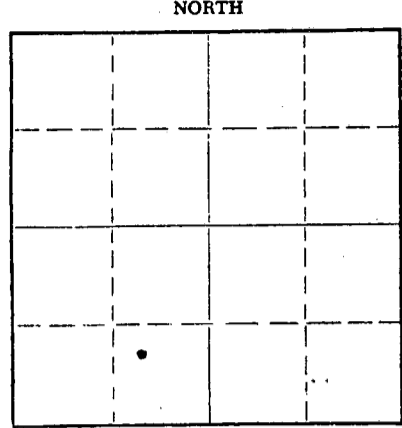

Locate well correctly on above Section Plat

Graham County, Sec. 36 Twp. 10S Rge. (E) 21 (W)  
Location as "NE/CNW/SW" or footage from lines C NW/SE/SW NE SW SE  
Lease Owner Cities Service Oil Company  
Lease Name Fondoble Well No. 8  
Office Address Box 553 Russell, Kansas 67665  
Character of Well (completed as Oil, Gas or Dry Hole) Oil  
Date well completed January 17 1956  
Application for plugging filed June 11 1965  
Application for plugging approved June 14 1965  
Plugging commenced September 9 1965  
Plugging completed September 9 1965  
Reason for abandonment of well or producing formation Non-Commercial

If a producing well is abandoned, date of last production July, 2 1965  
Was permission obtained from the Conservation Division or its agents before plugging was commenced? Yes

Name of Conservation Agent who supervised plugging of this well Mr. W. L. Nichols  
Producing formation Arbuckle Depth to top 3722' Bottom 3743' Total Depth of Well 3743 Feet  
Show depth and thickness of all water, oil and gas formations.

#### OIL, GAS OR WATER RECORDS

#### CASING RECORD

FORMATION	CONTENT	FROM	TO	SIZE	PUT IN	PULLED OUT
				8 5/8"	240'	None
				5 1/2"	3760'	None

Describe in detail the manner in which the well was plugged, indicating where the mud fluid was placed and the method or methods used in introducing it into the hole. If cement or other plugs were used, state the character of same and depth placed, from \_\_\_\_\_ feet to \_\_\_\_\_ feet for each plug set.

Measured up fluid at 87' from surface  
Mixed and pumped in 35 sacks Jell down 5 1/2" Casing at 400#  
Mixed 75 sacks cement and pumped in 5 1/2" Casing  
Cut 5 1/2" casing off at base of cellar and welded on cap  
Plugging complete at 5 P.M. 9-9-65.


**RECEIVED**  
STATE CORPORATION COMMISSION  
OCT 5 1965  
CONSERVATION DIVISION  
Wichita, Kansas

(If additional description is necessary, use BACK of this sheet)  
Name of Plugging Contractor Halliburton Company  
Address Hays, Kansas

STATE OF Kansas, COUNTY OF Russell, ss.  
M. M. Hardin (employee of owner) or (owner or operator) of the above-described well, being first duly sworn on oath, says: That I have knowledge of the facts, statements, and matters herein contained and the log of the above-described well as filed and that the same are true and correct. So help me God.

(Signature) *M.M. Hardin* M.M. Hardin, Dist. Supt.  
Box 553 Russell, Kansas 67665  
(Address)

SUBSCRIBED AND SWORN TO before me this 1st day of October, 1965

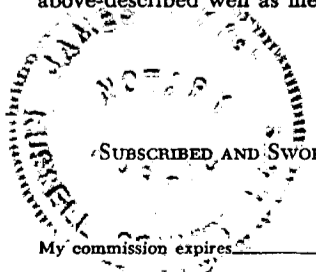

*James F. Kyger* James F. Kyger  
Notary Public.



15-065-01816-0000

# WELL RECORD

Company Cities Service Oil Co. Well No. 8 Farm Pondoble  
 Location 990' North and 990' East of S/4 Cor. Sec. 36 T. 10 R. 21W  
 Elevation 2139 (2137 Gr.) County Wichita State Kansas  
 Drlg. Comm. January 1, 1956 Contractor Lohmann-Johnson Drlg. Co., Inc.  
 Drlg. Comp. January 17, 1956 Acid 500 gals. 1-18-56  
 T. D. 3743' Initial Prod. Physical Potential: 174 oil, no water, 24 hrs. (1-20-56)

**CASING RECORD:**

8-5/8" @ 240' cem. 175 sz cement  
 5-1/2" @ 3723' cem. 150 sz cement

**FORMATION RECORD:**

sand & shale 0-240  
 shale 935  
 sand & red bed 1585  
 anhydrite 1610  
 shale, shells & lime 2000  
 shale & lime 2445  
 lime & shale 2870  
 lime 3725  
 lime & shale 3728  
 3728 RTD = 3725 SLK  
 lime 3743 T. D.

Corr. Topoka 3166'  
 Corr. Heebner 3374'  
 Corr. Dodge 3398'  
 Corr. Lansing 3412'  
 Corr. Conglomerate 3659'  
 Corr. Eros. Simpson 3704'  
 Corr. Arbuckle 3722'  
 Penetration 21'  
 Total Depth 3743'

SLOPE TESTS (SYFO): 500' 1°  
 1000' 1°  
 1500' 1°  
 2000' 1°  
 2500' 0°  
 3000' 1°  
 3500' 1°

7-7/8" rotary hole.

**RECEIVED**  
 STATE CORPORATION COMMISSION

JUN 14 1955

CONSERVATION DIVISION  
 Wichita, Kansas