


WELL PLUGGING RECORD

Give All Information Completely
Make Required Affidavit
Mail or Deliver Report to:
Conservation Division
State Corporation Commission
211 No. Broadway
Wichita, Kansas

Graham County. Sec. 22 Twp. 10S Rge. (E) 22W (W)

Location as "NE/CNW/SW" or footage from lines NW NW NE
Lease Owner JOHN O. FARMER, INC.
Lease Name FAUKNER Well No. 1
Office Address Russell, Kansas
Character of Well (completed as Oil, Gas or Dry Hole) Dry
Date well completed 1/11 1959
Application for plugging filed 1/11 1959
Application for plugging approved 1/11 1959
Plugging commenced 1/11 1959
Plugging completed 1/11 1959
Reason for abandonment of well or producing formation Dry

NORTH

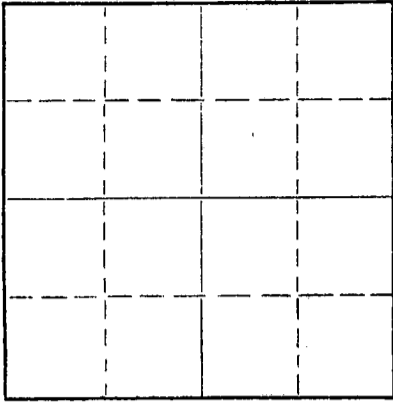

Locate well correctly on above
Section Plat

If a producing well is abandoned, date of last production _____ 19____
Was permission obtained from the Conservation Division or its agents before plugging was commenced? yes

Name of Conservation Agent who supervised plugging of this well Fabricius, Hill City, Kansas
Producing formation _____ Depth to top _____ Bottom _____ Total Depth of Well 3775 Feet
Show depth and thickness of all water, oil and gas formations.

OIL, GAS OR WATER RECORDS

CASING RECORD

FORMATION	CONTENT	FROM	TO	SIZE	PUT IN	PULLED OUT
				8-5/8"	160*	None

Describe in detail the manner in which the well was plugged, indicating where the mud fluid was placed and the method or methods used in introducing it into the hole. If cement or other plugs were used, state the character of same and depth placed, from _____ feet to _____ feet for each plug set.

First plug set at 600 feet with 20 sacks cement

Second plug set at 160 feet with 20 sacks cement

Third plug set at 40 feet with 10 sacks cement

RECEIVED
STATE CORPORATION COMMISSION

JAN 16 1959

CONSERVATION DIVISION
Wichita, Kansas

(If additional description is necessary, use BACK of this sheet)
Name of Plugging Contractor JOHN O. FARMER, INC.
Address RUSSELL, KANSAS

STATE OF KANSAS COUNTY OF RUSSELL, ss.
I, JOHN O. FARMER (owner or operator) of the above-described well, being first duly sworn on oath, says: That I have knowledge of the facts, statements, and matters herein contained and the log of the above-described well as filed and that the same are true and correct. So help me God.

(Signature) John O. Farmer
Russell, Kansas (Address)

Subscribed and Sworn to before me this 14th day of January, 1959
My commission expires October 11, 1962
Lucille Kennedy
Notary Public.

PLUGGING
FILE SEC. 22 T. 10 R. 22W
BOOK PAGE 11 LINE 10



