


Give All Information Completely  
Make Required Affidavit  
Mail or Deliver Report to:  
Conservation Division  
State Corporation Commission  
800 Biting Building  
Wichita, Kansas

WELL PLUGGING RECORD

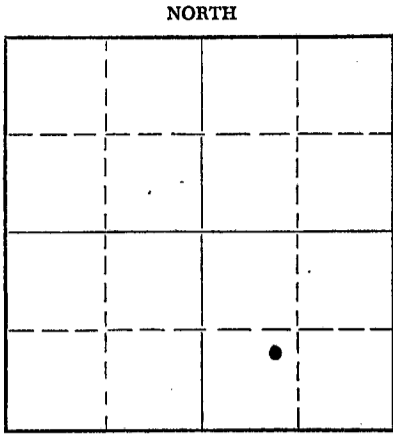

Graham County. Sec. 27 Twp. 10 Rge. 22 (E) W (W)  
Location as "NE/CNW%SW%" or footage from lines NE SW SE  
Lease Owner Wood River Oil & Refining Co., Inc.  
Lease Name Faulkner B Well No. 1  
Office Address 321 W. Douglas, Wichita 2, Kansas  
Character of Well (completed as Oil, Gas or Dry Hole) Oil  
Date well completed July 1 19 45  
Application for plugging filed April 19 19 54  
Application for plugging approved April 20 19 54  
Plugging commenced May 6 19 54  
Plugging completed May 14 19 54  
Reason for abandonment of well or producing formation Would not produce oil in commercial quantities.  
If a producing well is abandoned, date of last production April 17 19 54  
Was permission obtained from the Conservation Division or its agents before plugging was commenced? Yes

Locate well correctly on above Section Plat  
Name of Conservation Agent who supervised plugging of this well Eldon Petty  
Producing formation Kansas City Depth to top 3649 Bottom 3653 Total Depth of Well 3980 1/2 Feet  
Show depth and thickness of all water, oil and gas formations.

OIL, GAS OR WATER RECORDS

CASING RECORD

FORMATION	CONTENT	FROM	TO	SIZE	PUT IN	PULLED OUT
Top Topeka		3377		13"	285'	None
Heebuer Shales		3555	3560	8 5/8"	1838'	None
Toronto Dodge		3574		5 1/2"	3964'	727'
Lansing K C	Oil & Water	3594	3823			
Mississippi Chert		3895	3962			
Arbuckle		3962	3973			


Describe in detail the manner in which the well was plugged, indicating where the mud fluid was placed and the method or methods used in introducing it into the hole. If cement or other plugs were used, state the character of same and depth placed, from \_\_\_\_\_ feet to \_\_\_\_\_ feet for each plug set.  
Dumped 5 sacks of cement at 3940'. Shot pipe off at 727'. Pulled pipe and mudded hole to 300'. Set rock bridge and dumped 15 sacks of cement at 300'. Finished mudding hole and dumped 10 sacks of cement at base of cellar.

Name of Plugging Contractor Bert Self (If additional description is necessary, use BACK of this sheet)  
Address R. R. #4, Hutchinson, Kansas

STATE OF Kansas, COUNTY OF Sedgwick, ss.  
Employee (employee of owner) or (owner or operator) of the above-described well, being first duly sworn on oath, says: That I have knowledge of the facts, statements, and matters herein contained and the log of the above-described well as filed and that the same are true and correct. So help me God.

(Signature) Walter H. Siler  
321 W. Douglas, Wichita 2, Kansas (Address)

SUBSCRIBED AND SWORN to before me this 8th day of June, 19 54  
My Commission Expires Dec. 24, 1955

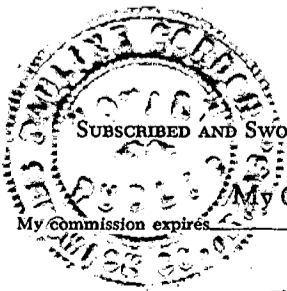

Pauline Gordon Notary Public.

24-7368-S 3-53-20M

RECEIVED  
STATE CORPORATION COMMISSION

JUN 9 - 1954

CONSERVATION DIVISION  
Wichita, Kansas

PLUGGING  
FILE SEC 27 T 10 R 22W  
BOOK PAGE 28 LINE 25

Wood River Oil & Refining Co.  
Faulkner B-1

Sec. 27 Twp. 10 Rge. 22  
County: Graham, Kansas

Total Depth: 3973'  
Comm: 6/11/45 Comp: 7/2/45

Casing	Cement
12 Jts 13 3/8" Set at 285'	225 Sacks
1838' 8 5/8" Set at 1838'	
3964' 5 1/2" Set at 3964'	200 Sacks

Formation:	Depth:
Shale	65'
Shale & Shells	760
Sand	810
Shale & Shells	860
Sand	930
Sand & Shale	990
Shale & Shells	1070
Sand, Shells, Iron	1095
Hard Sand & Iron	1100
Hard Sand	1130
Sand, Shale, Iron	1220
Sand & Shale	1300
Sand	1575
Red Rock & Shale	1823
Anhydrite	1868
Shale	1885
Shale & Shells	2145
Red Bed, Shale & Shells	2325
Lime & Shale Brks.	2425
Lime & Shale	2675
Lime	2695
Lime & Shale	2810
Shale	2830
Lime & Shale	3454
Lime, Shale & Chert	3495
Lime	3798
Shale & Lime	3905
Chert & Lime	3925
Chert, Lime, & Shale	3960
Shale	3962
Lime	3973

State of Kansas )  
                          ) SS  
Russell County (

I hereby certify that the above information is true and correct to the best of my knowledge.

Clara Hummel

Subscribed and sworn to before me this 2nd day of July, 1945

Genevieve Poole  
Notary Public  
My Comm. Expires 7/2/49

