

15-065-02950-0000

STATE OF KANSAS
STATE CORPORATION COMMISSION

WELL PLUGGING RECORD

OR

FORMATION PLUGGING RECORD

Strike out upper line
when reporting plugging
off formations.

Give All Information Completely
Make Required Affidavit
Mail or Deliver Report to:
Conservation Division
State Corporation Commission
800 Bitting Building
Wichita, Kansas

Graham

27 10 22

County. Sec. Twp. Rge. (E) (W)

Location as "NE $\frac{1}{4}$ NW $\frac{1}{4}$ SW $\frac{1}{4}$ " or footage from lines SW NE SE

Lease Owner Wood River Oil & Refg. Co.

Lease Name Faulkner A

Well No. 2

Office Address 335 W. Lewis St., Wichita, Kans.

Character of Well (completed as Oil, Gas or Dry Hole) Dry

Date, well completed July 30, 19 45

Application for plugging filed July 10 19 47

Application for plugging approved July 10 19 47

Plugging Commenced July 23 19 47

Plugging Completed July 26 19 47

Reason for abandonment of well or producing formation Dry

If a producing well is abandoned, date of last production None 19

Was permission obtained from the Conservation Division or its agents before plugging was commenced? Yes

Name of Conservation Agent who supervised plugging of this well C. D. Stough

Producing formation Kans. City Im. Depth to top 3379 Bottom 3643 Total Depth of Well 4000 Feet

Show depth and thickness of all water, oil and gas formations.

OIL, GAS OR WATER RECORDS

CASING RECORD

Formation	Content	From	To	Size	Put In	Pulled Out
Sh., Sg. & Anhyd.	Water	0	1817	8 5/8"	1817	None
Shale & Lime	"	0	4000	5 1/2"	3998'	2899'

Describe in detail the manner in which the well was plugged, indicating where the mud fluid was placed and the method or methods used in introducing it into the hole. If cement or other plugs were used, state the character of same and depth placed, from feet to feet for each plug set.


Run Bailer to check hole, then set cement plug at 3370 with ten sacks, to 3300'.

Knocked 5 1/2" casing off at 2899' and pulled same.

Filled hole with mud to 1800' & set cement plug from 1800 to 1760' w/ ten sacks.

Filled hole with mud from 1760 to 200' & set cement plug from 200' to 160' with ten sacks cement.

Filled hole with mud from 160' to cellar and capped surface with ten sack cement plug.

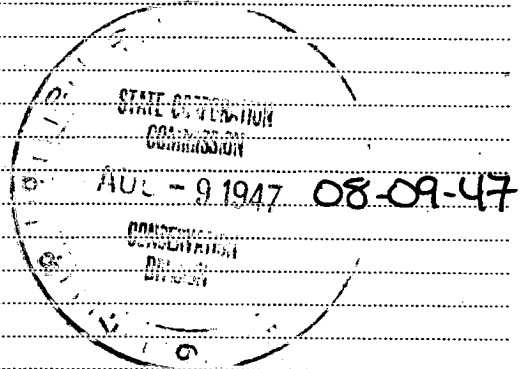

(If additional description is necessary, use BACK of this sheet)

Correspondence regarding this well should be addressed to Wood River Oil & Ref. Co.

Address 335 W. Lewis St., Wichita, Ks.

STATE OF Kans, COUNTY OF Sedgewick, ss.

V. E. Wiggins (employee of owner) or (owner or operator) of the above-described well, being first duly sworn on oath, says: That I have knowledge of the facts, statements, and matters herein contained and the log of the above-described well as filed and that the same are true and correct. So help me God.

(Signature) V. E. Wiggins

(Address)

SUBSCRIBED AND SWORN to before me this 4th day of August 19 47

Notary Public

My commission expires May 12, 1951



PLUGGING
FILE SEC 27 T 10 R 22W
BOOK PAGE 123 LINE 16

15-065-02950-0000

Wood River Oil & Refining Co.
H. Faulkner #2

Sec. 27 Twp. 10 Rge. 22
County: Graham, Kansas

Total Depth: 4000'
Comm: 7/3/45 Comp: 7/24/45

Casing
70 jts. 8 5/8" Set at 1817'
132 jts. 5 1/2" Set at 3998'

Cement
950 sacks
200 sacks

Formations:	Depth:
Sand & Shale	170'
Shale & Shells	735
Sand	785
Shale & Shells	1025
Hard sand & iron	1180
Sand & iron	1260
Sand & shale	1575
Sand & shells	1610
Shale & shells	1715
Shale, sand & iron	1802
Anhydrite	1810
Anhydrite	1845
Redbed & shale	1875
Redbed, shale & shells	2130
Shale & Lime shells	2320
Lime & shale	3525
Lime	3545
Lime & shale	3561
Lime	3635
chert & lime	3660
Lime	3690
Lime	3750
Lime & shale	3805
Lime	3820
Shale & lime	3855
Lime & shale	3890
Chert & lime	3918
Shale & Lime	3960
Lime	4000

State of Kansas)
) 33
Russell County)

I hereby certify that the above information is true and correct to the best of my knowledge.

Clara Hummel

Subscribed and sworn to before me this 28th day of July, 1945.

Jenevieve Poole
Notary Public

My Commission expires 7/2/49.

PLUGGING
FILE SEC 27 T10 R 320
BOOK PAGE 123 LINE 16

1948