

15-065-02949-0000

WELL PLUGGING RECORD

OR

FORMATION PLUGGING RECORD

Strike out upper line when reporting plugging off formations.


STATE OF KANSAS STATE CORPORATION COMMISSION

Give All Information Completely Make Required Affidavit Mail or Deliver Report to: Conservation Division State Corporation Commission 800 Bittig Building Wichita, Kansas

Graham County. Sec. 27 Twp. 10 Rge. 22 (E) W.(W)

Location as "NE 1/4 NW 1/4 SW 1/4" or footage from lines... SW 1/4
Lease Owner: J.A.Davis & J.H.Child, Agents
Lease Name: Faulkner Well No. 1
Office Address: Hutchinson, Kansas
Character of Well (completed as Oil, Gas or Dry Hole) Dry Hole
Date well completed July 16, 19. 47
Application for plugging filed July 16 19. 47
Application for plugging approved July 16 19. 47
Plugging commenced Afternoon July 16 19. 47
Plugging completed July 16 19. 47
Reason for abandonment of well or producing formation Dry

NORTH

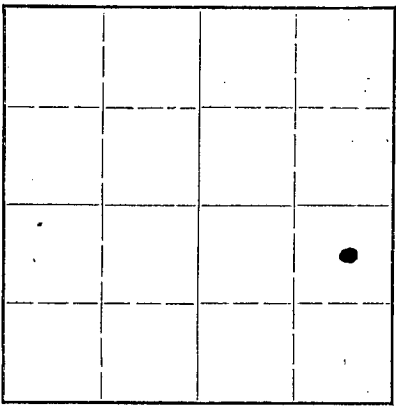

Locate well correctly on above Section Plat

If a producing well is abandoned, date of last production 19.
Was permission obtained from the Conservation Division or its agents before plugging was commenced? Yes

Name of Conservation Agent who supervised plugging of this well Stough
Producing formation Depth to top Bottom Total Depth of Well 3668 Feet
Show depth and thickness of all water, oil and gas formations.


OIL, GAS OR WATER RECORDS

CASING RECORD

Table with 7 columns: Formation, Content, From, To, Size, Put In, Pulled Out. All cells are empty.

Describe in detail the manner in which the well was plugged, indicating where the mud fluid was placed and the method or methods used in introducing it into the hold. If cement or other plugs were used, state the character of same and depth placed, from feet to feet for each plug set.

Hole was pumped full of heavy mud to bottom of surface pipe, bridged and cemented through drill stem with 15 sacks of cement at bottom and 10 sacks at top.
All under supervision of your Mr. Stough.

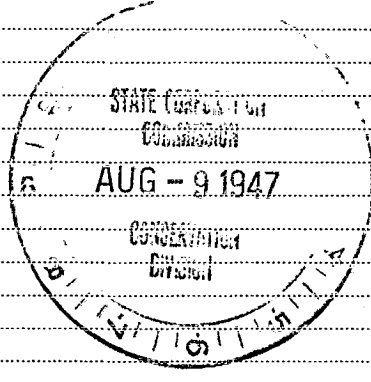

(If additional description is necessary, use BACK of this sheet)

Correspondence regarding this well should be addressed to J.A.Davis & J.H.Child, Agents, Hutchinson, Ks.
Address Hutchinson, Ks.

STATE OF Kansas COUNTY OF Reno
J.H.Child (employee of owner) or (owner or operator) of the above-described well,

being first duly sworn on oath, says: That I have knowledge of the facts, statements, and matters herein contained and the log of the above-described well as filed and that the same are true and correct. So help me God.

(Signature) [Handwritten Signature]
(Address)

SUBSCRIBED AND SWORN TO before me this 8 day of August, 19. 47

My commission expires 8-30-48 Notary Public.

21-6858-RS 2-47-6M

PLUGGING FILE SEC 27 T 10 R 22W BOOK PAGE 120 LINE 39

15-065-02949-0000

WELL LOG ----- FAULKNER #1

Location - SW/4 of Section 27-10-22W, Graham County, Kansas

Owner - J. A. Davis and J. H. Child, Agents
Contractor - Sterling Drilling Company

Commenced - July 6, 1947
Completed - July 16, 1947

Total Depth - 3668' (with rotary)

Casing Record

266' 2-5/8" Surface Pipe
Cemented with 175 Sacks Cement

LOG

0- 250	Surface
250-1540	Shale
1540-1790	Lime & Shale
1790-1820	Anhydrite
1820-2175	Shale & Lime
2175-2375	Shale & Shells
2375-2650	Shale & Lime
2650-2790	Lime
2790-3435	Shale & Lime
3435-3500	Lime
3500-3555	Lime & Shale
3555-3595	Shale & Shells
3595-3668	Lime

Production

None. Dry
(Abandoned)

Total Depth - 3668'

GRAHAM COUNTY
KANSAS
WELL LOG

WELL LOG
GRAHAM COUNTY
KANSAS



PLUGGING
FILE SEC 27-10-22W
BOOK PAGE 120 LINE 39






