


STATE OF KANSAS
STATE CORPORATION COMMISSION

Give All Information Completely
Make Required Affidavit
Mail or Deliver Report to:
Conservation Division
State Corporation Commission,
800 Bittling Building,
Wichita, Kansas

15-065-03417-0000
RECEIVED
WELL PLUGGING RECORD
OR
FORMATION PLUGGING RECORD
NOV 24 1936
Strike out upper line when reporting plugging of formations.

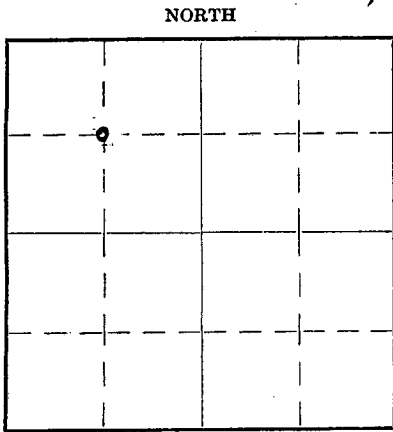

Locate well correctly on above Section Plat

Graham County. Sec. *27* Twp. *10* Rge. *22* (E) (W)
Location as "NE $\frac{1}{4}$ NW $\frac{1}{4}$ SW $\frac{1}{4}$ " or footage from lines Center NW $\frac{1}{4}$
Lease Owner *S. A. Murphy and J. S. Alcorn*
Lease Name *Wamhoff* Well No. *1*
Office Address *Box 14 Winfield, Kansas*
Character of Well (Completed as Oil, Gas or Dry Hole) *Dry hole*
Date, well completed. *Oct 31-36* 19...
Application for plugging filed. *Oct 31-36* 193...
Application for plugging approved. *Oct 31-36* 193...
Plugging Commenced. *Nov 1-36* 193...
Plugging Completed. *Nov 1-36* 193...
Reason for abandonment of well or producing formation.....

If a producing well is abandoned, date of last production..... 193...
Was permission obtained from the Conservation Division or its agents before plugging was commenced? *Yes* *J. C. Alexander*
Producing formation *none* Depth to top..... Bottom..... Total Depth of Well *4123* Feet
Show depth and thickness of all water, oil and gas formations.

OIL, GAS OR WATER RECORDS				CASING RECORD		
Formation	Content	From	To	Size	Put In	Pulled Out
				<i>12 1/2</i>	<i>77ft</i>	<i>none</i>

Describe in detail the manner in which the well was plugged, indicating where the mud fluid was placed and the method or methods used in introducing it into the hole. If cement or other plugs were used, state the character of same and depth placed, from.....feet to.....feet for each plug set.


*Heavy mud was Pumped in Hole from 4123 to 265 ft
Cement Plug from 265 to 250 Heavy mud from 250 to 5 ft
Cement from 5 to top of ground
The 77ft of Surface Pipe was left in the hole
It was cemented solid on out side*

PLUGGING
FILE NO. *2710R224*
BOOK PAGE *68* LINE *13*

(If additional description is necessary use BACK of this sheet)
Correspondence regarding this well should be addressed to.....
Address *Box 14 Winfield Kansas*

STATE OF *Kansas* COUNTY OF *Ellis*, ss.
Geo Pullork (employee of owner) or (owner or operator) of the above-described well,
being first duly sworn on oath, says: That I have knowledge of the facts, statements, and matters herein contained and the log of the above-described well as filed and that the same are true and correct. So help me God.

(Signature) *Geo Pullork*
Waye Kansas (Address)
SUBSCRIBED AND SWORN to before me this *19th* day of *Nov.*, 19*36*.

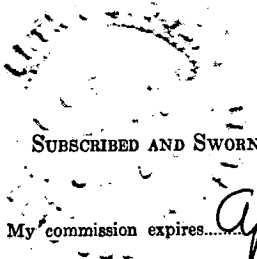

My commission expires *Apr. 16, 1938*
16-1484 11-35-5M Notary Public.

Wamhoff # 1 Center NW 1/4 Section 27-10-22 Graham County, Kansas
 Company - S. A. Murphy & J. S. Alcorn
 Contractor - S. A. Murphy
 Commenced - September 21, 1936
 Completed to Siliceous Lime - October 29, 1936
 Total Depth - 4123

15-065-03417-0000

FORMATION	DEPTH
Shale & Shells 77' of 12 1/2"	0- 77
Grey Shale	77- 250
White Clay	250- 300
Shale & Shells	300- 600
Broken Lime	600- 625
Shale & Shells	625- 775
Soft Sand & Shells Dakota	775- 935
Sand & Shells	935-1050
Grey Shale & Shells	1050-1147
Soft Sand & Shale	1147-1175
Broken Lime	1175-1204
Broken Lime & Sand	1204-1250
Shale & Red Rock	1250-1300
Soft Sand & Shale	1300-1565
Red Bed & Shale	1565-1815
Anhydrite	1815-1860
Broken Anhydrite	1860-1885
Red Bed & Shale	1885-1960
Red Bed Shale & Shells	1960- 2092
Blue Shale & Shells	2092-2125
Blue & Brn Shale & Shells	2125-2185
Brn & Blue Shale	2185-2210
Salt & Shale	2210-2260
Brn Shale & Shells	2260-2293
Lime	2293-2313
Lime & Brn Shale	2313-2350
Grey Lime	2350-2360
Brn Shale & Shells	2360-2380
Lime	2380-2438
Lime & Shale	2438-2460
Shale & Shells	2460-2505
Lime	2505- 2530
Broken Lime	2530-2576
Broken Grey Lime	2576-2604
Lime & Shale	2604-2719
Brn Shale & Broken Lime	2719-2840
Brn Shale & Lime	2840-2860
Blue Shale & Lime	2860-3054
Shale & Shells	3054-3084
Blue Shale & Shells	3084-3187
Shale & Lime	3187-3220
Lime	3220-3235
Shale & Lime	3235-3324
Shale & Shells	3324-3355
Topeka Lime	3355-3382
Lime	3382- 3387
Broken Lime	3387-3505
Shale	3505-3515
Lime	3515-3545
Broken Lime	3545-3557
Lime	3557-3577
Correction on measurement Steel Line	-3586
Lime & Shale	3586-3599
Lime S	3599-3604
Core Sample Lime S	3604-3614
Broken Lime & Shale	3614-3623
Lime	3623-3643
Core Samples Lime & Shale	3643-3657
Broken Lime	3657-3725
Lime	3725-3749

FORMATION	DEPTH
Broken Lime	3749-3832
Red & Blk Shale & Lime Shells	3832-3878
Red & Blk Shale & Lime	3878-3888
Broken Lime	3888-3913
Conglomerate	3913-3997
Core Sample Cong.	3997-4004
Conglomerate	4004-4006
Cong. & Brn Shale	4006-4074
Conglomerate	4074-4086
Cong. & Pyrites very hard	4086-4091
Core Sample Lime	4091-4104
Lime Cong.	4104-4116
Lime	4116-4118
Core Sample Lime	4118-4123
Top Siliceous	4106-4123

Total Depth 4123

Now comes S. A. Murphy, who states that he is familiar with drilling of oil and gas wells and he personally knows that the Wamhoff # 1 located in the Center of The Northwest Quarter of Section 27-10-22 Graham County, Kansas, was drilled to a total depth of 4123 feet to Siliceous Lime and same was a dry hole - plugged and abandoned.

S. A. Murphy
 By *M. J. Williams*

PLUGGING
 FILE NO. 27 10 224
 BOOK PAGE 68 LINE 13