

15-005-02381-0000

STATE OF KANSAS
STATE CORPORATION COMMISSION

WELL PLUGGING RECORD


Give All Information Completely
Make Required Affidavit
Mail or Deliver Report to:
Conservation Division
State Corporation Commission
211 No. Broadway
Wichita, Kansas

GRAHAM

County. Sec. **32** Twp. **10S** Rge. **22** (W) (W)

Location as "NE/CNW%SW%" or footage from lines **SE, SW, NW**
Lease Owner **Colorado Oil & Gas Company**
Lease Name **Griffith "A"** Well No. **1**
Office Address **430 West Douglas Wichita, Kansas**
Character of Well (completed as Oil, Gas or Dry Hole) **Dry Hole**
Date well completed **June 18, 19 57**
Application for plugging filed **June 18, 19 57**
Application for plugging approved **June 18, 19 57**
Plugging commenced **June 18, 19 57**
Plugging completed **June 18, 19 57**
Reason for abandonment of well or producing formation **No productable zone**

NORTH

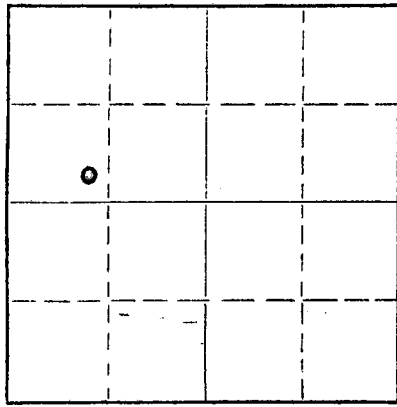

Locate well correctly on above Section Plat

If a producing well is abandoned, date of last production **----** 19**---**
Was permission obtained from the Conservation Division or its agents before plugging was commenced? **Yes**

Name of Conservation Agent who supervised plugging of this well **Mr. Eldon Petty**
Producing formation **---** Depth to top **---** Bottom **---** Total Depth of Well **4000'** Feet
Show depth and thickness of all water, oil and gas formations.

OIL, GAS OR WATER RECORDS

CASING RECORD

FORMATION	CONTENT	FROM	TO	SIZE	PUT IN	PULLED OUT
				8 5/8"	@ 207'	

Describe in detail the manner in which the well was plugged, indicating where the mud fluid was placed and the method or methods used in introducing it into the hole. If cement or other plugs were used, state the character of same and depth placed, from _____ feet to _____ feet for each plug set.

Built up heavy mud filling hole with same up to 200', using 1/2 sx. hulls pushed plug to 200' and placed 20 sx. cement through drill pipe. Used heavy mud up to 40', using 1/2 sx. hulls, pushed plug to 40' and placed 10 sx. cement to base of well cellar. Job complete @ 11:00 AM, 6-18-57

(If additional description is necessary, use BACK of this sheet)

Name of Plugging Contractor **Garvey Drilling Company**
Address **R. R. #2 Great Bend, Kansas**

STATE OF **KANSAS** COUNTY OF **BARTON** ss.
Verne A. Morris (employee of owner) or **XXXXXXX** of the above-described well, being first duly sworn on oath, says: That I have knowledge of the facts, statements, and matters herein contained and the log of the above-described well as filed and that the same are true and correct. So help me God.


(Signature) Verne A. Morris
R. R. #2 Great Bend, Kansas
(Address)

SUBSCRIBED AND SWORN TO before me this **15th** day of **July**, 19 **57**

My commission expires **November 12, 1958**

Beaufort
Notary Public.

PLUGGING
FILE SEC 32 T. 10 R. 22W
BOOK PAGE 22 LINE 8

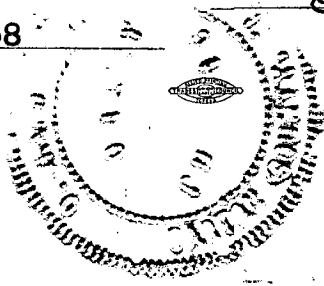

RECEIVED
STATE CORPORATION COMMISSION

JUL 17 1957

CONSERVATION DIVISION
Wichita, Kansas

15-065-02381-0000

COLORADO OIL & GAS CORPORATION

32 10S 22W

GRIFFITH 'A'

1

SE,SW,NW

4000'

Graham Co., Kansas

June 7, 1957

June 18, 1957

GARVEY DRILLING COMPANY

8 5/8" @ 207' W/150 sax.

2286' DF

D & A

50	Clay
160	Blue shale
208	Blue shale & shells
335	Blue shale
700	Shale
860	Sand
930	Hard sand streaks
1235	Shale & sand streaks
1290	Red bed & shale
1550	Dakota sand
1780	Blue shale & shells
1825	Anhydrite
2275	Shale & shells
3205	Lime & shale
3308	Lime
3512	Lime & shale
3957	Lime
3973	Conglomerate
3992	Simpson shale
4000	Lime
4000	T. D.

KANSAS

BARTON

Verne A. Morris

RECEIVED

CORPORATION COMMISSION

JUN 17 1957

Garvey Drilling Co.

#1 Griffith 'A'

PLUGGING DIVISION			
FILE	SEC. 32	T. 10	R. 22W
BOOK	PAGE 22	LINE 8	

24th

June

57

Verne A. Morris.

November 12, 1958

Brantburg

