


Give All Information Completely  
Make Required Affidavit  
Mail or Deliver Report to:  
Conservation Division  
State Corporation Commission  
212 North Market, Insurance Bldg.  
Wichita, Kansas

WELL PLUGGING RECORD

15-065-02649-0000

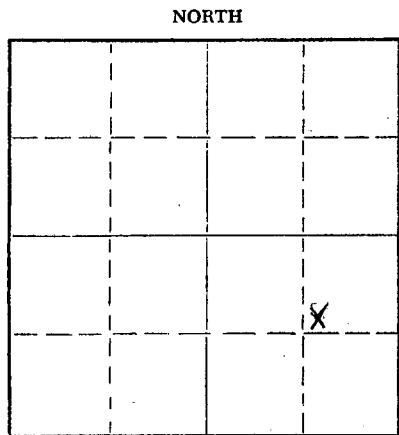

Locate well correctly on above Section Plat

GRAHAM County. Sec. 31 Twp. 10 Rge. 22 (E) W (W)  
Location as "NE/CNW&SW" or footage from lines SW NE SE  
Lease Owner MORRIS ON PRODUCING COMPANY  
Lease Name MCCALL Well No. 1  
Office Address P. O. BOX 712, EL DORADO, KANSAS  
Character of Well (completed as Oil, Gas or Dry Hole) DRY HOLE  
Date well completed DECEMBER 15 19 63  
Application for plugging filed DECEMBER 15 19 63  
Application for plugging approved DECEMBER 15 19 63  
Plugging commenced 1:00 P. M., DECEMBER 15 19 63  
Plugging completed 3:00 P. M., DECEMBER 15 19 63  
Reason for abandonment of well or producing formation DRY HOLE

If a producing well is abandoned, date of last production 19  
Was permission obtained from the Conservation Division or its agents before plugging was commenced? YES

Name of Conservation Agent who supervised plugging of this well W. L. NICHOLS, MORLAND, KANSAS  
Producing formation Depth to top Bottom Total Depth of Well 3825 Feet  
Show depth and thickness of all water, oil and gas formations.

OIL, GAS OR WATER RECORDS

CASING RECORD

FORMATION	CONTENT	FROM	TO	SIZE	PUT IN	PULLED OUT
		0	222	7"	222	

Describe in detail the manner in which the well was plugged, indicating where the mud fluid was placed and the method or methods used in introducing it into the hole. If cement or other plugs were used, state the character of same and depth placed, from feet to feet for each plug set.

PLUGGED w/15 SX CEMENT @ 550', 15 SX CEMENT @ 210',  
10 SX @ 40' TO SURFACE.

RECEIVED  
STATE CORPORATION COMMISSION

DEC 23 1963  
12-23-63

CONSERVATION DIVISION  
Wichita, Kansas

(If additional description is necessary, use BACK of this sheet)

Name of Plugging Contractor CHEMICAL & TECHNICAL SERVICES, INC.  
Address P. O. BOX D, HILL CITY, KANSAS

STATE OF KANSAS, COUNTY OF GRAHAM, ss.  
D. F. MCCARTHY (employee or operator) of the above-described

well, being first duly sworn on oath, says: That I have knowledge of the facts, statements, and matters herein contained and the log of the above-described well as filed and that the same are true and correct. So help me God.

(Signature) D. F. McCarthy  
P. O. BOX D, HILL CITY, KANSAS (Address)

SUBSCRIBED AND SWORN to before me this 21st day of December, 1963



Dora Saylor  
Notary Public.

CONTRACTOR'S WELL LOG

15-065-02649-0000

CONTRACTOR:  
OWNER:  
WELL:  
LOCATION:  
COMMENCED:  
COMPLETED:

CHEMICAL & TECHNICAL SERVICES, INC.  
MORRISON PRODUCING COMPANY  
MCCALL #1  
SW NE SE SEC. 31-10S-22W  
GRAHAM CO., KANSAS  
12/6/63  
12/15/63

			ELEVATION:		
0	45	SURFACE CLAY & SHALE		GROUND LEVEL	2310'
45	480	SHALE		DERRICK FLOOR	2315'
480	1680	SHALE & SAND		KELLY BUSHING	2317'
1680	1822	SHALE & RED BED			
1822	1866	ANHYDRITE			
1866	2358	SHALE			
2358	3551	LIME & SHALE			
3551	3635	LIME			
3635	3665	LIME & SHALE			
3665	3755	LIME			
3755	3825	LIME & SHALE			
3825		ROTARY TOTAL DEPTH			

SET 7" SURFACE CASING @ 222' w/135 SACKS CEMENT

DRY & ABANDONED

WE HEREBY CERTIFY THIS TO BE A CORRECT AND ACCURATE LOG OF THE ABOVE DESCRIBED WELL,  
AS SHOWN ON THE DAILY DRILLING REPORTS.

CHEMICAL & TECHNICAL SERVICES, INC.

BY: *D. J. McCarthy*  
ASST. TREASURER

SUBSCRIBED AND SWORN TO BEFORE THIS 14 DAY OF DECEMBER, 1963.

*Esteeck*

*Anna Presler*  
NOTARY PUBLIC



*nearcopy Onion Skin*

RECEIVED  
STATE CORPORATION COMMISSION

DEC 23 1963

CONSERVATION DIVISION  
Wichita, Kansas

RECEIVED  
STATE CORPORATION COMMISSION

DEC 23 1963

CONSERVATION DIVISION  
Wichita, Kansas