


WELL PLUGGING RECORD

Give All Information Completely  
Make Required Affidavit  
Mail or Deliver Report to:  
Conservation Division  
State Corporation Commission  
211 No. Broadway  
Wichita, Kansas

NORTH

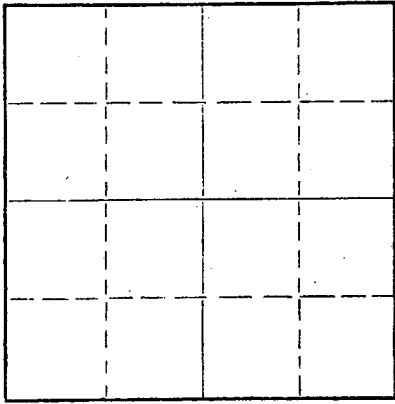

Locate well correctly on above  
Section Plat

Graham County, Sec. 6 Twp. 10S Rge. 23W (E) (W)  
Location as "NE/CNW/SW" or footage from lines NW SE SE  
Lease Owner Imperial Oil of Kansas, Inc.  
Lease Name Johnson "B" Well No. 3  
Office Address Wichita 2, Kansas  
Character of Well (completed as Oil, Gas or Dry Hole) Dry Hole  
Date well completed May 17, 19 58  
Application for plugging filed May 17, 19 58  
Application for plugging approved May 17, 19 58  
Plugging commenced May 17, 19 58  
Plugging completed May 17, 19 58  
Reason for abandonment of well or producing formation No commercial quantities of oil found.  
If a producing well is abandoned, date of last production \_\_\_\_\_ 19 \_\_\_\_  
Was permission obtained from the Conservation Division or its agents before plugging was commenced? Yes

Name of Conservation Agent who supervised plugging of this well A. D. Fabricius, Box 731, Hill City, Ks.  
Producing formation \_\_\_\_\_ Depth to top \_\_\_\_\_ Bottom \_\_\_\_\_ Total Depth of Well 3980 Feet  
Show depth and thickness of all water, oil and gas formations.

OIL, GAS OR WATER RECORDS

CASING RECORD

FORMATION	CONTENT	FROM	TO	SIZE	PUT IN	PULLED OUT
				8-5/8"	5-7-58	

Describe in detail the manner in which the well was plugged, indicating where the mud fluid was placed and the method or methods used in introducing it into the hole. If cement or other plugs were used, state the character of same and depth placed, from \_\_\_\_\_ feet to \_\_\_\_\_ feet for each plug set.

Set No. 1 plug at 550' with 25 sacks cement. Set No. 2 plug at 220' with 15 sacks cement. No. 3 plug at 40' with 10 sacks cement.

**RECEIVED**  
STATE CORPORATION COMMISSION  
MAY 29 1958  
CONSERVATION DIVISION  
Wichita, Kansas

(If additional description is necessary, use BACK of this sheet)  
Name of Plugging Contractor Imperial Oil of Kansas, Inc.  
Address 780 Fourth National Building, Wichita 2, Kansas

STATE OF KANSAS, COUNTY OF SEDGWICK, ss.  
Raymond L. Bacon (employee of ~~owner~~ owner) of the above-described well, being first duly sworn on oath, says: That I have knowledge of the facts, statements, and matters herein contained and the log of the above-described well as filed and that the same are true and correct. So help me God, IMPERIAL OIL OF KANSAS, INC.  
(Signature) By: Ray L Bacon E-P  
780 Fourth National Bldg., Wichita 2, Kansas (Address)



SUBSCRIBED AND SWORN to before me this 26th day of May, 19 58  
Louetta M. Duncan  
Notary Public.

PLUGGING  
FILE SEC. 6 T. 10 R. 23W  
BOOK PAGE 102 LINE 27

RECEIVED  
STATE CORPORATION COMMISSION

MAY 29 1958

CONSERVATION DIVISION  
Wichita, Kansas

DRILLER'S LOG

Imperial Oil of Kansas, Inc.  
780 Fourth National Building  
Wichita 2, Kansas

Johnson "B" No. 3  
NW SE SE Sec. 6-10S-23W  
Graham County, Kansas

Total Depth: 3980'

Elevation: 2428' RB  
Production: D & A

Commenced: 5-8-58 Completed: 5-17-58

Contractor: Imperial Oil of Kansas, Inc.  
Wichita 2, Kansas

Casing Record: Set 8-5/8" Surface Pipe at 220' with 150 sacks cement.

Figures indicate bottom of formations:

			<u>TOPS</u>
Surface Hole	220'		
Shale & Shells	320'	Anhydrite	2038' ( / 390 )
Shale, Sand & Shells	1245'	Heebner	3744' (-1316)
Shale & Shells	2038'	Toronto	3767' (-1339)
Anhydrite	2076'	Lansing	3784' (-1355)
Shale & Shells	2480'	Rotary Total Depth	3980' (-1552)
Lime & Shale	3780'		
Lime	3980'		
Total Depth	3980'		

We hereby certify this to be a correct and accurate log of the above described well as shown on the daily drilling reports.

IMPERIAL OIL OF KANSAS, INC.

By: Ray C. L. [Signature]  
Vice President

Subscribed and sworn to before me this 26th day of May, 1958.

My Commission Expires:

December 19, 1960

[Signature]  
Notary Public

<b>PLUGGING</b>			
FILE	SEC <u>6</u>	T. <u>10</u>	R. <u>23W</u>
BOOK	PAGE <u>102</u>	LINE <u>27</u>	

