


Give All Information Completely
Make Required Affidavit
Mail or Deliver Report to:
Conservation Division
State Corporation Commission
211 No. Broadway
Wichita, Kansas

WELL PLUGGING RECORD

NORTH

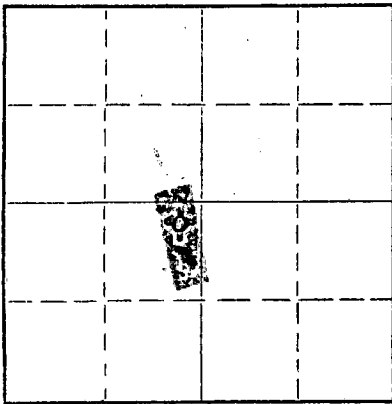

Locate well correctly on above Section Plat

Graham County. Sec. 6 Twp. 10 Rge. 23W (E) (W)
Location as "NE/CNW/SW" or footage from lines NE NE SW
Lease Owner D. G. Hansen
Lease Name Gano A RT KCC Well No. 21
Office Address Logan, Kansas
Character of Well (completed as Oil, Gas or Dry Hole) Dry Hole
Date well completed December 15 1958
Application for plugging filed December 15 1958
Application for plugging approved December 15 1958
Plugging commenced December 15 1958
Plugging completed December 16 1958
Reason for abandonment of well or producing formation Too low structurally

If a producing well is abandoned, date of last production 19
Was permission obtained from the Conservation Division or its agents before plugging was commenced? Yes

Name of Conservation Agent who supervised plugging of this well Eldon Petty, Hays, Kansas
Producing formation _____ Depth to top _____ Bottom _____ Total Depth of Well 4040 Feet
Show depth and thickness of all water, oil and gas formations.

OIL, GAS OR WATER RECORDS

CASING RECORD

FORMATION	CONTENT	FROM	TO	SIZE	PUT IN	PULLED OUT
				8-5/8"	213.96'	none

Describe in detail the manner in which the well was plugged, indicating where the mud fluid was placed and the method or methods used in introducing it into the hole. If cement or other plugs were used, state the character of same and depth placed, from _____ feet to _____ feet for each plug set.

Filled hole with heavy mud to 550'. Set plug. Put in 20 sacks cement. Filled to 200'. Set plug. Put in 1/2 sack hulls and 15 sacks cement. Filled with heavy mud up to 40'. Set plug. Filled to top with 1/2 sack hulls and 10 sacks cement.

RECEIVED
STATE CORPORATION COMMISSION
JAN 14 1959 01-14-59

RECEIVED

DEC 21 1958

CONSERVATION DIVISION
Wichita, Kansas

D. G. Hansen,
BY _____

(If additional description is necessary, use BACK of this sheet)

Name of Plugging Contractor C-G Drilling Co.
Address 107 Rule Building, Wichita 2, Kansas

STATE OF KANSAS, COUNTY OF SEDGWICK, ss.
G. F. Galloway (employee of owner) or (owner or operator) of the above-described well, being first duly sworn on oath, says: That I have knowledge of the facts, statements, and matters herein contained and the log of the above-described well as filed and that the same are true and correct. So help me God.

(Signature) G. F. Galloway
107 Rule Building
(Address)

SUBSCRIBED AND SWORN to before me this 19th day of December, 1958

My commission expires May 20, 1959

Vicky Jacobs
Vicky Jacobs Notary Public.

PLUGGING
FILE SEC 6 T. 10 R. 23W
BOOK PAGE 9 LINE 13

15-065-19216-0000

CONTRACTOR'S WELL LOG

OPERATOR D. G. Hansen WELL NAME Gano #2 ^{A #1}

LOCATION NE NE SW SEC. 6-10-23W RIG NO. 1 ^{RT FCC}

COUNTY Graham STATE Kansas

COMMENCEMENT DATE December 8, 1958 COMPLETION DATE December 16, 1958

LOG OF WELL

Elevation 2447' kelly bushing.
 All measurements taken from the top of kelly bushing.

FROM	TO	FORMATION	DEVIATION FROM VERTICAL	REMARKS:
0	214	Sand-Shale		
214	775	Sand-Shale		
775	1775	Sand-Shale		
1775	2058	Shale		
2058	2094	Anhydrite		
2094	2275	Shale		
2275	2520	Lime-Shale	0° - 2500	
2520	2765	Shale-Lime	0° - 2750	
2765	2930	Shale-Lime		
2930	3065	Lime-Shale	0° - 3000	
3065	3200	Lime-Shale		
3200	3340	Shale-Lime	0° - 3250	
3340	3473	Lime-Shale		
3473	3600	Lime-Shale		
3600	3700	Lime-Shale		
3700	3774	Lime-Shale		
3774	3845	Lime-Shale		
3845	3895	Lime-Shale		
3895	3967	Lime-Shale		
3967	4040	Lime-Shale		

RECEIVED
STATE CORPORATION COMMISSION

JAN 14 1959

CONSERVATION DIVISION
Wichita, Kansas

DST 3945-3967'

CASING LEFT IN HOLE AFTER COMPLETION

Ran 213.96' (11 jts.) 8-5/8" OD Surface Casing.

STATE OF KANSAS }
 COUNTY OF SEDGWICK } SS.

The undersigned hereby certifies that to the best of his knowledge and belief, the above facts are true and correct.


C-G DRILLING CO.

By G. F. Galloway
 G. F. Galloway

SUBSCRIBED AND SWORN TO BEFORE ME THIS 19th day of December, 1958.

Vicky Jacobs
 Vicky Jacobs, Notary Public

My commission expires:

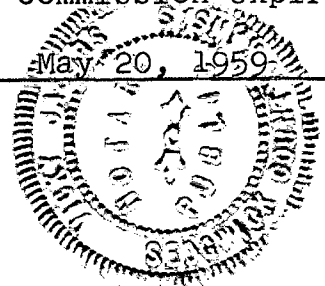

RECEIVED

DEC 21 1958

PLUGGING
 FILE SEC. 6 T. 10 R. 23W
 BOOK PAGE 9 LINE 13

D. G. Hansen,
 BY _____