


Give All Information Completely  
Make Required Affidavit  
Mail or Deliver Report to:  
Conservation Division  
State Corporation Commission  
211 No. Broadway  
Wichita, Kansas

WELL PLUGGING RECORD

GRAHAM County, Sec. 7 Twp. 10 Rge. 23 (E) W (W)

Location as "NE/CNW/SW" or footage from lines NW NW SW  
Lease Owner DANE G HANSEN TRUST  
Lease Name KERMAN #1 Well No.  
Office Address P O BOX 187, LOGAN, KANSAS  
Character of Well (completed as Oil, Gas or Dry Hole) DRY & ABANDONED  
Date well completed JULY 20, 1966 19  
Application for plugging filed JULY 20, 1966 19  
Application for plugging approved JULY 20, 1966 19  
Plugging commenced JULY 20, 1966 19  
Plugging completed JULY 20, 1966 19  
Reason for abandonment of well or producing formation TOO LOW STRUCTURALLY

NORTH

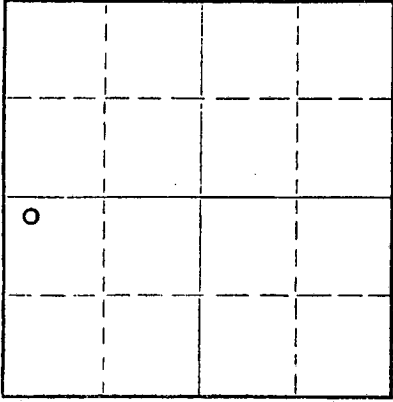

Locate well correctly on above  
Section Plat

If a producing well is abandoned, date of last production 19  
Was permission obtained from the Conservation Division or its agents before plugging was commenced? YES

Name of Conservation Agent who supervised plugging of this well W. L. NICHOLS, MORELAND, KANSAS  
Producing formation Depth to top Bottom Total Depth of Well 4025 Feet  
Show depth and thickness of all water, oil and gas formations.

OIL, GAS OR WATER RECORDS

CASING RECORD

FORMATION	CONTENT	FROM	TO	SIZE	PUT IN	PULLED OUT
				8-5/8"	193.45	None

Describe in detail the manner in which the well was plugged, indicating where the mud fluid was placed and the method or methods used in introducing it into the hole. If cement or other plugs were used, state the character of same and depth placed, from feet to feet for each plug set.

FILLED WITH HEAVY MUD TO 540'. Set  
PLUG. PUT IN 20 SX CEMENT. FILLED  
WITH HEAVY MUD TO 180'. SET PLUG.  
PUT IN 1/2 SX HULLS AND 20 SX CEMENT.  
FILLED WITH HEAVY MUD UP TO 40'. SET  
PLUG. FILLED TO TOP WITH 10 SX CEMENT.


RECEIVED  
STATE CORPORATION COMMISSION  
JUL 28 1966  
CONSERVATION DIVISION  
Wichita, Kansas

(If additional description is necessary, use BACK of this sheet)  
Name of Plugging Contractor C-G DRILLING COMPANY  
Address 107 RULE BUILDING, WICHITA, KANSAS 67202

STATE OF KANSAS COUNTY OF SEDGWICK  
JAY H. GALLOWAY (employee of owner) or (owner or operator) of the above-described well, being first duly sworn on oath, says: That I have knowledge of the facts, statements, and matters herein contained and the log of the above-described well as filed and that the same are true and correct. So help me God.

(Signature) Jay H Galloway  
JAY H GALLOWAY 107 RULE BUILDING  
(Address)

25 day of JULY, 19 66

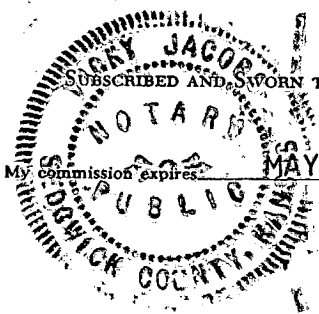

Vicky Jacobs Notary Public.

W E L L   L O G

OPERATOR: DANE G HANSEN TRUST  
 WELL NAME: KERMAN #1 LOCATION: NW NW SW Sec 7-10-23W  
 COUNTY: GRAHAM STATE: KANSAS  
 WELL COMMENCED: 7-12-66 WELL COMPLETED: 7-20-66  
 ELEVATION: 2442 KB TOTAL DEPTH: 4025'  
 PRODUCTION: DRY & ABANDONED RIG NO: 1  
 CASING - 8-5/8": 10 jts. 193,45' W/140 sx cement 2 sx cal. cl.  
 5-1/2": \_\_\_\_\_

All Measurements taken from the top of rotary bushing.

FROM	TO	FORMATION	DEVIATION FROM VERTICAL		REMARKS:
0	965	SHALE & SAND	1000'	3/4°	
965	1590	SHALE	1500'	1/4°	
1590	1800	SAND	2000'	1°	
1800	2030	SHALE	2500'	3/4°	
2030	2060	RED BED	3000'	3/4°	
2060	2095	ANHYDRITE			
2095	2275	SHALE & SHELLS			
2275	2570	SHALE			
2570	3770	LIME & SHALE			DST #1 3938 - 3956
3770	4025	LIME			DST #2 3975 - 4025

**RECEIVED**  
 STATE CORPORATION COMMISSION  
 JUL 28 1966  
 CONSERVATION DIVISION  
 Wichita, Kansas

STATE OF KANSAS  
 COUNTY OF SEDGWICK ) SS:

The undersigned hereby certifies that to the best of his knowledge and belief, the above facts are true and correct.

C-G DRILLING CO.

By Jay H. Galloway  
 JAY H. GALLOWAY

SUBSCRIBED AND SWORN TO, BEFORE ME, This 25 day of JULY, 1966.

My comm. exp: May 20, 1967

Vicky Jacobs  
 Vicky Jacobs - Notary Public

