

STATE OF KANSAS
STATE CORPORATION COMMISSION


WELL PLUGGING RECORD

Give All Information Completely
Make Required Affidavit
Mail or Deliver Report to:
Conservation Division
State Corporation Commission
212 North Market, Insurance Bldg.
Wichita, Kansas

Graham County, Sec. 11 Twp. 10S Rge. 21W (E) (W)

Location as "NE/CNW/SW" or footage from lines NW NW NW
Lease Owner John O. Farmer, Inc.
Lease Name Miller Well No. 1
Office Address Box 352, Russell, Kansas 67665
Character of Well (completed as Oil, Gas or Dry Hole) oil
Date well completed June 19 50
Application for plugging filed January 19 73
Application for plugging approved January 5 19 73
Plugging commenced 3/19 19 73
Plugging completed 3/19 19 73
Reason for abandonment of well or producing formation Depleted

NORTH

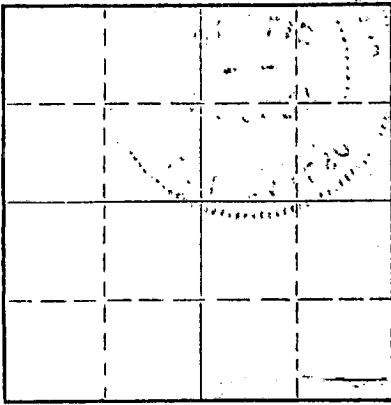

Locate well correctly on above Section Plat

If a producing well is abandoned, date of last production June 19 67
Was permission obtained from the Conservation Division or its agents before plugging was commenced? Yes

Name of Conservation Agent who supervised plugging of this well W. L. Nichols
Producing formation Arbuckle Depth to top 3839 Bottom 3845 Total Depth of Well 3845 Feet
Show depth and thickness of all water, oil and gas formations.

OIL, GAS OR WATER RECORDS

CASING RECORD

FORMATION	CONTENT	FROM	TO	SIZE	PUT IN	PULLED OUT


Describe in detail the manner in which the well was plugged, indicating where the mud fluid was placed and the method or methods used in introducing it into the hole. If cement or other plugs were used, state the character of same and depth placed, from _____ feet to _____ feet for each plug set.

Used Pump Truck
Mix 1 sx hulls - 25 cu ft. cement - 30 sx. Gel - 125 cu. ft. cement
150 cu. ft. cement Between 5-1/2" & 8-5/8" casg. Pressure @ 600#

RECEIVED
STATE CORPORATION COMMISSION
5-26-1973
MAR 26 1973
CONSERVATION DIVISION
Wichita, Kansas

(If additional description is necessary, use BACK of this sheet)
Name of Plugging Contractor Allied Cementing Company
Address Russell, Kansas 67665

STATE OF KANSAS, COUNTY OF RUSSELL, ss.
JOHN O. FARMER, President (employee of owner) or (owner or operator) of the above-described well, being first duly sworn on oath, says: That I have knowledge of the facts, statements, and matters herein contained and the log of the above-described well as filed and that the same are true and correct. So help me God.

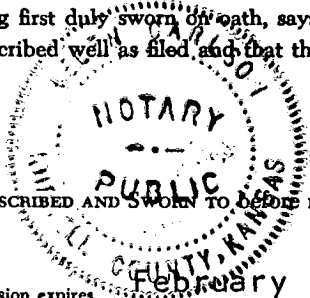

(Signature) John O. Farmer
Box 352, Russell, Kansas 67665
(Address)

SUBSCRIBED AND SWORN TO before me this 23rd day of March 19 73
Helen Carlson Notary Public.
My commission expires February 15, 1975

J-S-F No. 1

Jones, Shelburne & Farmer, Inc.

Russell, Kansas

CONTRACTOR'S VERIFIED LOG

Operator **JONES, SHELBERNE & FARMER, INC.** Farm Name **MILNER** Well No **1**

Location **NM, NE, NW SECTION 11-109-21N**

Pool Name **WILDCAT** County **GRAHAM** State **KANSAS**

Commencement Date **June 14, 1950** Completion Date **June 26, 1950**

Log of Well

Depth		Formation	Deviation from vertical (degrees)	Remarks
From	To			
0	150	Soil & Shale		
150	1220	Shale & Shells		
1220	1500	Sand & Shale		
1500	1760	Shale & Shells		
1760	1810	Anhydrite		
1810	2350	Shale & Shells		
2350	2625	Shale & Lias		
2625	2819	Lias		
	2819	Total Rotary Depth		

RECEIVED
 STATE CORPORATION COMMISSION
 JAN 5 1973
 1-5-1973
 CONSERVATION DIVISION
 Wichita, Kansas

