

15-065-02373-00-00 *see*

STATE OF KANSAS  
STATE CORPORATION COMMISSION

WELL PLUGGING RECORD

Give All Information Completely  
Make Required Affidavit  
Mail or Deliver Report to:  
Conservation Division  
State Corporation Commission  
800 Bittig Building  
Wichita, Kansas

Graham County. Sec. 14 Twp. 10S Rge. (E) 21 (W)

Location as "NE/CNW/SW" or footage from lines C S/2 NE/4 SE/4

Lease Owner Skelly Oil Company

Lease Name C. R. Acheson Well No. 6

Office Address Box 1650, Tulsa, Oklahoma

Character of Well (completed as Oil, Gas or Dry Hole) Dry Hole

Date well completed August 16, 19 54

Application for plugging filed August 17, 19 54


Application for plugging approved August 18, 19 54

Plugging commenced August 18, 19 54

Plugging completed August 23, 19 54

Reason for abandonment of well or producing formation Dry Hole

NORTH

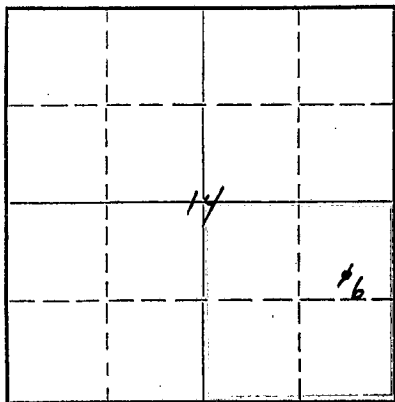

Locate well correctly on above  
Section Plat

If a producing well is abandoned, date of last production \_\_\_\_\_ 19 \_\_\_\_\_

Was permission obtained from the Conservation Division or its agents before plugging was commenced? Yes

Name of Conservation Agent who supervised plugging of this well Mr. Warren H. Horner

Producing formation \_\_\_\_\_ Depth to top \_\_\_\_\_ Bottom \_\_\_\_\_ Total Depth of Well 3811 Feet

Show depth and thickness of all water, oil and gas formations.

OIL, GAS OR WATER RECORDS

CASING RECORD

FORMATION	CONTENT	FROM	TO	OD SIZE	PUT IN	PULLED OUT
Arbuckle Lime	Dry	3780'	3811'	8-5/8"	311'0"	None
					3814'3"	3132'10"

Describe in detail the manner in which the well was plugged, indicating where the mud fluid was placed and the method or methods used in introducing it into the hole. If cement or other plugs were used, state the character of same and depth placed, from \_\_\_\_\_ feet to \_\_\_\_\_ feet for each plug set.

5 sacks of cement	3811' to 3771'
Mud laden fluid	3771' to 3209'
Mud laden fluid	3209' to 318'
100 sacks of cement	318' to 6'
Surface soil	6' to 0'

RECEIVED  
STATE CORPORATION COMMISSION  
9-11-1954  
SEP 11 1954

Name of Plugging Contractor Ace Pipe Pulling Company  
Address Great Bend, Kansas

STATE OF Kansas, COUNTY OF Reno, ss.

H. E. Wamsley (employee of owner ~~Box 391, Hutchinson, Kansas~~) of the above-described well, being first duly sworn on oath, says: That I have knowledge of the facts, statements, and matters herein contained and the log of the above-described well as filed and that the same are true and correct. So help me God.

(Signature) \_\_\_\_\_

Box 391, Hutchinson, Kansas  
(Address)


SUBSCRIBED AND SWORN TO before me this 10th day of September, 19 54

My commission expires April 7, 1955 \_\_\_\_\_  
Notary Public.

24-7366-S 3-53-20M

PLUGGING  
FILE SEC 14 T 10 R 21W  
BOOK PAGE 52 LINE 1

# SKELLY OIL COMPANY

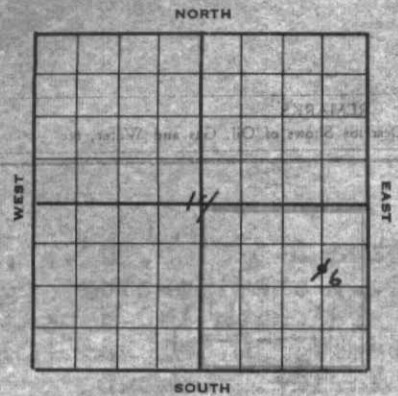

## Well Record

Lease Name and No. P. B. Johnson Well No. 6 Elev. 2216' NH  
 Lease Description 1/4 Section 14-100-218,  
Graham County, Kansas (160 Acres)  
 Location made July 19, 1954 by P. J. Gussen  
990 feet from North line 660 feet from East line 81/4  
 feet from South line feet from West line of Sec. 14

Work com'd. 7/23 1954 Rig comp'd 7/24 1954 Drlg. com'd 7/24 1954 Drlg. comp'd 8/15 1954

Rig Contractor Claude Wentworth Drilling Co., Inc.  
 Drilling Contractor Claude Wentworth Drilling Co., Inc., Tulsa, Oklahoma

Rotary Drilling from 0' to 3786' Cable Tool Drilling from 3786' to 3811'

Commenced Producing DRY HOLE 1954 { Initial Prod. before shot or acid Bbls.  
 Initial Prod. after shot or acid Bbls.  
 Dry Gas Well Press Volume Cu. ft.  
 Casing Head Gas Pressure Volume Cu. ft.  
 Braden Head ( Size ) Gas Pressure Volume Cu. ft.  
 Braden Head ( Size ) Gas Pressure Volume Cu. ft.

PRODUCING FORMATION DRY HOLE (Name) Top Bottom TOTAL DEPTH 3811'

### CASING RECORD

Size	Wt.	Thds.	Where Set	PULLED OUT			LEFT IN			KIND	Cond'n	CEMENTING	
				Jts.	Feet	In.	Jts.	Feet	In.			Sacks Used	Method Employed
8-5/8" 22.7	BJ	318'					8	311	0	Araco SW A	150	Halliburton	
5-1/2" 14.8	BR	3786'		2441	0	22	681	5		J55 R2 R22 B			
5-1/2" 14.8	BR			17	691	10				J55 R3 R22 B	250	Halliburton	
(8-5/8" casing set 1' in cellar and 3/4" cased to derrick floor)													

Liner Set at Length Perforated at  
 Liner Set at Length Perforated at  
 Packer Set at Size and Kind  
 Packer Set at Size and Kind

### SHOT OR ACID TREATMENT RECORD

	FIRST	SECOND	THIRD	FOURTH
Date	8/10/54	8/12/54	8/13/54	
Acid Used	250 Gals.	500 Gals.		
Size Shot	250 Qts.			
Shot Between	3779 Ft. and 3786 Ft.	3779 Ft. and 3794 Ft.	3777 Ft. and 3794 Ft.	
Size of Shell				
Put in by (Co.)	Halliburton	Halliburton	Halliburton	
Length anchor				
Distance below Cas'g			and-Oil-Trac	
Damage to Casing or Casing Shoulder				

### SIGNIFICANT GEOLOGICAL FORMATIONS

NAME	Top	Bottom	GAS		OIL		REMARKS
			From	To	From	To	
Heebner Shale	3438'						
Toronto Lias	3463'						
Lansing Lias	3480'						
Conglomerate	3778'						
Arbuckle Lias	3780'						9-11-1954

### CLEANING OUT RECORDS

	DATE COMMENCED	DATE COMPLETED	PROD. BEFORE	PROD. AFTER	REMARKS
1st					See Reverse for other details.
2nd					" " " " "
3rd					" " " " "
4th					" " " " "

### PLUGGING BACK AND DEEPENING RECORDS

	Date Commenced	Date Completed	No. Feet Plugged Back or Deepened	Prod. Before	Prod. After	REMARKS
1st						See Reverse for other details.
2nd						" " " " "
3rd						" " " " "
4th						" " " " "

(See Reverse for Record of Formation)

**PLUGGING**  
 P&L SEC-14-10-R-210  
 BOOK PAGE 57

# RECORD OF FORMATIONS

FORMATION	TOP	BOTTOM	REMARKS
Surface soil, fine sand and clay	0	260	
Sand and shale	318	700	
Shale and sand	700	1100	
Shale and shells	1100	1420	
Shale	1420	1440	
Anhydrite	1440	1475	
Shale	1475	1675	
Shale, shells and salt	1675	1935	
Shale and lime	1935	2215	
Lime	2215	2355	
Shale and lime	2355	2520	
Lime	2520	2600	
Shale and shells	2600	2755	
Shale and lime	2755	2895	
Shale	2895	2970	
Shale and lime	2970	3481	

FORMATION	TOP	BOTTOM	REMARKS
Cream, dense lime	3481	3489	
Lime	3489	3495	
Lime	3495	3521	
Cream, finely crystalline partly oolitic lime	3521	3528	
Lime	3528	3552	
Cream, finely crystalline cherty lime	3552	3558	
Lime	3558	3567	
Cream to tan, finely crystalline to dense fossiliferous lime	3567	3572	
Lime	3572	3650	
Cream, light tan, dense to chalky arenaceous lime	3650	3658	
Lime	3658	3675	
Cream to gray fine crystalline lime	3675	3683	
Lime	3683	3782	

FORMATION	TOP	BOTTOM	REMARKS
Medium crystalline dolomite	3782	3786	

Plugging

Set and cemented 3122' of 5 1/2" O.D., 14#, 88 lbs., J-55, A.S.T. steel casing (3 cond.); and 692' of 5 1/2" O.D., 14#, 88 lbs., J-55, A.S.T. casing (2 cond.) at 3122' with 160 sacks of regular cement, 3 1/2 gal and 100 lbs of calcium chloride. Cement circulated.

Finished at 10:00 midnight 8/4/54.

On August 10, perforated 5½" casing from 3779' to 3782' with 12 Lane-Wells cone shots, no fluid change. Ran 2" tubing and treated with 250 gallons of Halliburton 15% acid as follows:

ACID TREATMENT NO. 1 - Between 3779' and 3786'

Treatment put in 8/10/54 by Halliburton, using 250 gallons of acid and 91 barrels of oil to fill hole and flush.

TIME	GF	TF	REMARKS
5:20 pm			Filled hole with 91 barrels of oil
5:35 pm			Acid on bottom
7:35 pm	1000	900	65 gallons of acid in formation
7:55 pm	1350	1250	
8:15 pm	1300	1250	180 gallons of acid in formation
8:34 pm	1300	1300	250 gallons of acid in formation

Swabbed through 2" tubing 3 hours, 40 barrels of oil used in treating. Ran rods and POB 5 hours, 38 barrels of oil used in treating and well pumped off. On August 11, pulled rods and 2" tubing and swabbed and bailed the hole dry. Tested 2 gallons of oil and 4 gallons of water per hour. Drilled deeper as follows:

Gray and brown, finely crystalline dolomite	3786	3787	Poor porosity, slight stain, no increase in fluid
Same	3787	3788	
Same with slight trace of green shale	3788	3789	
Same	3789	3790	Tested 2 gallons of oil and 4 gallons of water per hour.
Gray and brown, medium crystalline dolomite with trace pink chert	3790	3792	Poor porosity and saturation, no increase in fluid
Same with very slight show of chert	3792	3794	No increase in fluid

Filled hole with 94 barrels of oil and treated with 500 gallons of Halliburton 15% acid as follows:

ACID TREATMENT NO. 2 - Between 3779' and 3794'

Treatment put in 8/12/54 by Halliburton, using 500 gallons of acid and 94 barrels of oil to fill hole and flush.

TIME	GF	TF	REMARKS
7:35 pm			Loading hole
8:00 pm			Start to spot acid
8:12 pm	300	0	acid on bottom
9:00 pm	1000	750	60 gallons of acid in formation
9:30 pm	1000	800	140 gallons of acid in formation
9:45 pm	750	650	260 gallons of acid in formation
10:00 pm	650	650	350 gallons of acid in formation
10:25 pm	650	650	500 gallons of acid in formation

Swabbed through 2" tubing 4 hours, 62 barrels of oil used in treating. Pulled 2" tubing and reran tubing with Halliburton SM packer. Filled hole with 70 barrels of oil and set packer at 3735'. Pressured annulus to 800. Well took 4½ barrels of oil per minute at 3500-TP on input test below packer. Treated with Halliburton Sand-Oil-Frac as follows:

SAND-OIL-FRAC TREATMENT NO. 1 - Between 3779' and 3794'

Used 1000 of sand  
30 barrels of heavy crude oil  
Maximum TF-4150, broke to 3300  
Used 156 barrels oil to fill and flush  
Time 1 hour and 55 minutes

Pulled tubing and packer and bailed hole clean. Swabbed through 5½" casing 3 hours, 96 barrels of oil used in treating. On August 14, swabbed through 5½" casing 4 hours, 30 barrels of oil used in treating with trace of water and swabbed to bottom. Bailed and tested 3 hours, 5 gallons of oil and 15 gallons of water per hour. Drilled deeper:

White to gray, medium hard finely crystalline dolomite	3794	3796	light porosity, no shows, no increase in fluid
Same	3796	3798	
Same	3798	3800	
Same	3800	3802	No increase in fluid
White to gray medium crystalline dolomite	3802	3804	Poor porosity with spotted heavy dead oil stain, no increase in fluid
Same with show of pyrites and green shale	3804	3806	No increase in fluid
Green shale	3806	3811	Hole started caving

TOTAL DEPTH 3811'

drilling to the total depth of 3811', regular authority was granted to plug and abandon the well.

On August 18, moved in machine of Ace Pipe Pulling Company and the well was plugged as follows:

5 sacks of cement	3811' to 3771'
Mud laden fluid	3771' to 3209'

Shot off 5 1/2" casing at 3122' and pulled 2441' of 5 1/2" OD, 14#, 88 S.W. steel casing (B cond.); and 692' of 5 1/2" OD, 14#, 88 thd., J-55, S.W. casing (B cond.).

Mud laden fluid	3209' to 318'
100 sacks of cement	318' to 6'
Surface soil	6' to 0'

Plugged and abandoned August 23, 1954.

*Carbeck*

*Carbeck*