

STATE OF KANSAS  
STATE CORPORATION COMMISSION

Give All Information Completely  
Make Required Affidavit  
Mail or Deliver Report to:  
Conservation Division  
State Corporation Commission  
211 No. Broadway  
Wichita, Kansas

WELL PLUGGING RECORD

Graham County. Sec. 14 Twp. 10S Rge. (E) 21 (W)

Location as "NE/CNWxSWx" or footage from lines. NE NE NW NE SE NW

Lease Owner ~~Driscoll~~ Peel-Hardman Oil Operators

Lease Name Driscoll Well No. 3

Office Address R. R. #3, Box 144B, Wichita 15, Kansas

Character of Well (completed as Oil, Gas or Dry Hole) Oil Well

Date well completed April 19 19 55

Application for plugging filed May 27 19 58

Application for plugging approved May 29 19 58


Plugging commenced July 7 19 58

Plugging completed July 11 19 58

Reason for abandonment of well or producing formation No longer a commercial Producer

If a producing well is abandoned, date of last production January 19 58

Was permission obtained from the Conservation Division or its agents before plugging was commenced? Yes

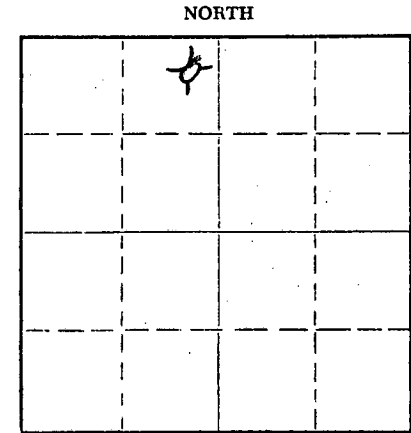

Locate well correctly on above Section Plat

Name of Conservation Agent who supervised plugging of this well A. D. Fabricus

Producing formation Arbuckle Depth to top 3768 Bottom Total Depth of Well 3776 1/2 Feet

Show depth and thickness of all water, oil and gas formations.

OIL, GAS OR WATER RECORDS

CASING RECORD

FORMATION	CONTENT	FROM	TO	SIZE	PUT IN	PULLED OUT
		0	171	8 5/8"	171	None
		0	3769	5 1/2 "	3769	3085

Describe in detail the manner in which the well was plugged, indicating where the mud fluid was placed and the method or methods used in introducing it into the hole. If cement or other plugs were used, state the character of same and depth placed, from \_\_\_\_\_ feet to \_\_\_\_\_ feet for each plug set.

- From 3776 1/2 to 3750 - Sand
- From 3750 to 3720 - 5 sacks Cement
- From 3720 to 160 - Heavy Rotary
- From 160 to 150 - Rock Bridge
- From 150 to 75 - 25 Sacks Cement
- From 75 to 35 - Heavy Rotary Mud
- From 35 to 30 - Rock Bridge
- From 30 to 0 - 10 Sacks Cement

(If additional description is necessary, use BACK of this sheet)

Name of Plugging Contractor Glenn & Smith Pipe Pulling Co.  
Address Box 114, Ellinwood, Kansas

STATE OF Kansas, COUNTY OF Sedgwick, ss. William Herbert


(employee of owner) or (owner or operator) of the above-described well, being first duly sworn on oath, says: That I have knowledge of the facts, statements, and matters herein contained and the log of the above-described well as filed and that the same are true and correct. So help me God:

(Signature) *William Herbert*  
R. R. #3, Box 144B, Wichita 15, Kansas (Address)

SUBSCRIBED AND SWORN to before me this 19th day of August, 19 58

My commission expires March 4, 1962

*Manna Herbert* Notary Public

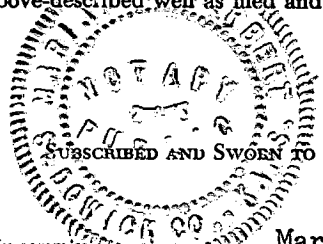

PLUGGING  
FILE SEC 14 T. 10 R. 21 W  
BOOK PAGE 104 LINE 6

RECORDED  
CORPORATION COMMISSION  
8/20/1958  
AUG 20 1958  
Wichita, Kansas

DRILLER'S LOG

Company: Peel-Hardman Oil Producers

NE SE NW  
Sec. 14 Twn.10 Rge.21

Farm: Driscoll Well No.: 3  
Total Depth: 3773'

County: Graham  
Kansas

Comm: 3-31-55 Comp.: 4-10-55

Contractor: Peel Brothers, Inc.

Elevation:

Casing: 8 5/8" @ 171' Cem.  
5 1/2" @ 3769' Cem.

Production:


Figures below indicate bottom of formation

Shale	0'	820'
Sand		900
Shale		1020
Sahle and sand		1545
Red bed and shale		1688
Anhydrite		1730
Shale		2450
Shale and Lime		3310
Lime		3485
Lime and shale		3540
Lime		3635
Lime and Shale		3663
Lime		3763
Shale		3768
Dolomite		3773
Total Depth		3773

This is to certify that the above information is, to the best of our knowledge, true and correct.

PEEL-HARDMAN OIL OPERATORS

BY: *W. J. Herbert*

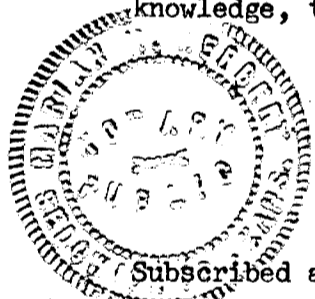

Subscribed and sworn to before me this 27th day of May, 1958.

My commission expires March 4, 1962.

*Marian M. Herbert*  
Notary Public

RECEIVED  
STATE CORPORATION COMMISSION  
5-29-1958  
MAY 29 1958  
CONSERVATION DIVISION  
Wichita, Kansas

PLUGGING  
FILE SEC. 14 T. 10 R. 21W  
BOOK PAGE 104 LINE 6