


STATE OF KANSAS  
STATE CORPORATION COMMISSION

Give All Information Completely  
Make Required Affidavit  
Mail or Deliver Report to:  
Conservation Division  
State Corporation Commission  
800 Bitting Building  
Wichita, Kansas

WELL PLUGGING RECORD

NORTH

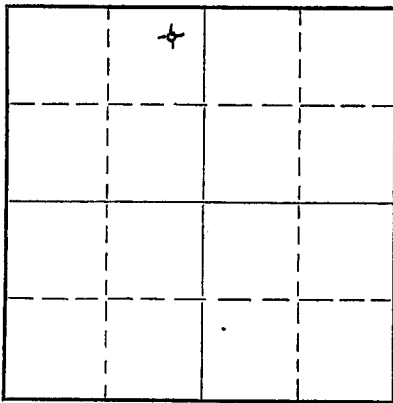

Locate well correctly on above  
Section Flat

Graham County, Sec. 14 Twp. 10S Rge. (E) 21 (W)  
Location as "NE/CNW 1/4 SW 1/4" or footage from lines NE NE NW  
Lease Owner Peel-Hardman  
Lease Name Driscoll Well No. 1  
Office Address P. O. Box 359, Hoisington, Kansas  
Character of Well (completed as Oil, Gas or Dry Hole) Dry Hole  
Date well completed Nov. 8 19 50  
Application for plugging filed Nov. 8 19 50  
Application for plugging approved Nov. 8 19 50  
Plugging commenced Nov. 8 19 50  
Plugging completed Nov. 8 19 50  
Reason for abandonment of well or producing formation Dry Hole

If a producing well is abandoned, date of last production 19  
Was permission obtained from the Conservation Division or its agents before plugging was commenced? Yes

Name of Conservation Agent who supervised plugging of this well E. R. Petty  
Producing formation Depth to top Bottom Total Depth of Well 3862 Feet  
Show depth and thickness of all water, oil and gas formations.

OIL, GAS OR WATER RECORDS

CASING RECORD

Formation	Content	From	To	Size	Put In	Pulled Out
		0'	153'	8 5/8"	153'	None

Describe in detail the manner in which the well was plugged, indicating where the mud fluid was placed and the method or methods used in introducing it into the hole. If cement or other plugs were used, state the character of same and depth placed, from feet to feet for each plug set.

3862' - 151 1/2' - Heavy Rotary Mud  
151 1/2' - 150' - Wooden Plug  
150' - 104' - 15 sacks cement  
104' - 41 1/2' - Heavy Rotary Mud  
41 1/2' - 40' - Wooden Plug  
40' - 6' - 10 sacks cement  
6' - Surface - Cellar

STATE CORPORATION COMMISSION  
11-21-1950  
NOV 21 1950


(If additional description is necessary, use BACK of this sheet)

Correspondence regarding this well should be addressed to Peel-Hardman Wichita, Kansas  
Address P. O. Box 359, Hoisington, Kansas

STATE OF Kansas, COUNTY OF Barton, ss.  
Glenn Peel Drilling Company, Inc. (employee of owner) or (owner or operator) of the above-described well,

being first duly sworn on oath, says: That I have knowledge of the facts, statements, and matters herein contained and the log of the above-described well as filed and that the same are true and correct. So help me God. GLENN PEEL DRILLING COMPANY, INC.

(Signature) BY: [Signature] P. O. Box 359, Hoisington, Kansas (Address)

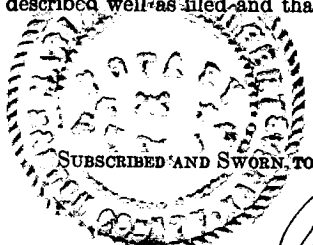

SUBSCRIBED AND SWORN to before me this 20th day of November, 19 50  
My commission expires June 4, 1951

PLUGGING  
FILE SEC 14 T 10 R 17 W  
BOOK PAGE 42 LINE 11

Notary Public.

DRILLER'S LOG

Company: Peel-Hardman  
Aurora Gasoline Company  
N. Appleman Company  
R. W. Shields

Sec. 14, Twp. 10S, Rge. 21W  
NE NE NW

Farm: Driscoll Well No. 1

County: Graham,  
Kansas

Total Depth: 3862'

Contractor: Glenn Peel Drilling Co., Inc.  
Comm.: 10-27-50 Comp.: 11-8-50  
Casing:  
8 5/8" 153' cem.

Elevation:  
Production: Dry

Figures below indicate bottom of formations

Blue Shale	0 -	143
Shale and Shells		720
Shale		765
Shale w/sand streaks		1000
Shale and Shells		1240
Sand		1455
Shale		1645
Shale and Red Bed		1695
Anhydrite		1730
Shale		1750
Sand, Shale and Shells		2010
Shale and Shells		2210
Shale		2405
Shale and Lime		2535
Lime and Shale		3419
Lime		3700
Lime and Conglomerate		3800
Conglomerate		3820
Arbuckle		3862
Total Depth		3862

This is to certify that the above information is, to the best of our knowledge, true and correct.

GLENN PEEL DRILLING COMPANY, INC.

BY: J.P. [Signature]



SUBSCRIBED AND SWORN to before me this 20<sup>th</sup> day of November, 1950

My commission expires June 4, 1951

Marion M. Herbert  
Notary Public

**PLUGGING**  
FILE SEC 14 T 10 R 21 W  
BOOK PAGE 42 LINE 11

**RECEIVED**  
STATE CORPORATION COMMISSION  
11-21-1950  
NOV 21 1950  
CONSERVATION DIVISION  
Wichita, Kansas