


WELL PLUGGING RECORD

Give All Information Completely  
Make Required Affidavit  
Mail or Deliver Report to:  
Conservation Division  
State Corporation Commission  
800 Bittling Building  
Wichita, Kansas

Graham County, Sec. 16 Twp. 10S Rge. 23W (E) (W)

Location as "NE/CNW $\frac{1}{4}$ SW $\frac{1}{4}$ " or footage from lines SW SE NW  
Lease Owner Imperial Drilling Company, Inc.  
Lease Name Stewart Well No. 1  
Office Address 903 Union Natl Bank Bldg., Wichita 2, Kansas  
Character of Well (completed as Oil, Gas or Dry Hole) Dry Hole  
Date well completed February 27, 1954  
Application for plugging filed February 26, 1954  
Application for plugging approved February 26, 1954  
Plugging commenced February 26, 1954  
Plugging completed February 27, 1954  
Reason for abandonment of well or producing formation  
No oil found in commercial quantities.  
If a producing well is abandoned, date of last production 19  
Was permission obtained from the Conservation Division or its agents before plugging was commenced? yes

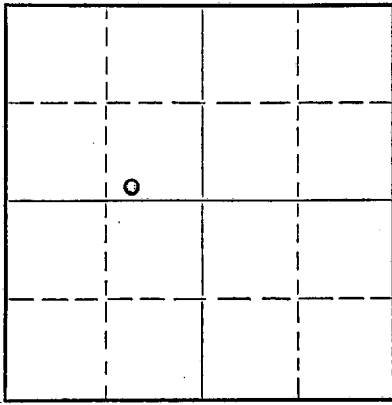

Locate well correctly on above Section Flat

Name of Conservation Agent who supervised plugging of this well Mr. Eldon Petty  
Producing formation Depth to top Bottom Total Depth of Well 4240 Feet  
Show depth and thickness of all water, oil and gas formations.

OIL, GAS OR WATER RECORDS

CASING RECORD

Formation	Content	From	To	Size	Put In	Pulled Out
				8-5/8"	218'	

Describe in detail the manner in which the well was plugged, indicating where the mud fluid was placed and the method or methods used in introducing it into the hole. If cement or other plugs were used, state the character of same and depth placed, from feet to feet for each plug set.

Set #1 plug at 200' with 20 sacks cement. Filled hole with rotary mud to 40'. Set #2 plug with 10 sacks cement.

03-04-54

(If additional description is necessary, use BACK of this sheet)

Name of Plugging Contractor Imperial Drilling Company, Inc.,  
Address 903 Union National Bank Building,  
Wichita 2, Kansas

STATE OF KANSAS, COUNTY OF SEDGWICK, ss.  
Raymond L. Bacon (employee of owner) or (owner or operator) of the above-described well, being first duly sworn on oath, says: That I have knowledge of the facts, statements, and matters herein contained and the log of the above-described well as filed and that the same are true and correct. So help me God.

(Signature) Imperial Drilling Company, Inc.  
By: Raymond L. Bacon - Pres.  
903 Union Natl Bank Bldg.,  
Wichita 2, Kansas  
(Address)

SUBSCRIBED AND SWORN to before me this 2nd day of March, 1954

My commission expires November 9, 1957

Notary Public

PLUGGING  
FILED SEC 16 T 10 R 23W  
BOOK PAGE 16 LINE 35

