

15-195-20239-00-00

STATE OF KANSAS
STATE CORPORATION COMMISSION


Form CP-4

Give All Information Completely
Make Required Affidavit
Mail or Deliver Report to:
Conservation Division
State Corporation Commission
212 No. Market
Wichita, Kansas 67202

WELL PLUGGING RECORD

Trego County, Sec. 9 Twp. 12 Rge. 22 (E) W (W)
Location as "NE/CNW/SW" or footage from lines C W/2 NW/4 NE/4
Lease Owner Black Petroleum Co.
Lease Name Babb Well No. 1
Office Address Suite 445 Olive W. Garvey Bldg.
Character of Well (completed as Oil, Gas or Dry Hole) Dry hole
Date well completed 1-8-1973
Application for plugging filed 1-8-1973
Application for plugging approved 1-8-1973
Plugging commenced 1-8-1973
Plugging completed 1-8-1973
Reason for abandonment of well or producing formation Dry hole

If a producing well is abandoned, date of last production 19____
Was permission obtained from the Conservation Division or its agents before plugging was commenced? Yes

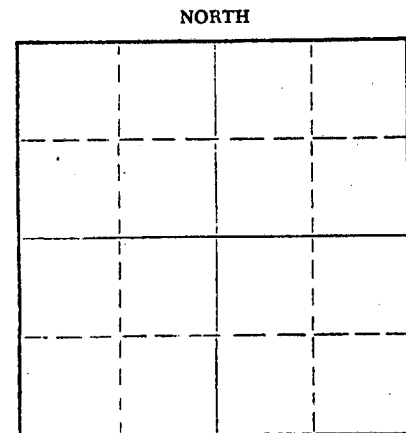

Locate well correctly on above Section Plat

Name of Conservation Agent who supervised plugging of this well Bill Nichols
Producing formation _____ Depth to top _____ Bottom _____ Total Depth of Well 4,108 Feet
Show depth and thickness of all water, oil and gas formations.

OIL, GAS OR WATER RECORDS

CASING RECORD

FORMATION	CONTENT	FROM	TO	SIZE	PUT IN	PULLED OUT
				8 5/8"	243'	Cmtd. w/150 sax

Describe in detail the manner in which the well was plugged, indicating where the mud fluid was placed and the method or methods used in introducing it into the hole. If cement or other plugs were used, state the character of same and depth placed, from _____ feet to _____ feet for each plug set.

Fill hole w/heavy mud
Set Bridge plug @900'
Pump 70 sax cement on plug thru 4 1/2" drill pipe
Fill hde w/heavy mud
Set Bridge plug @275'
Pump 30 sax cement on plug thru 4 1/2" drill pipe

RECEIVED
STATE CORPORATION COMMISSION
JAN 23 1973
01-23-1973
CONSERVATION DIVISION
Wichita, Kansas

(If additional description is necessary, use BACK of this sheet)

Name of Plugging Contractor Shields Drilling Co., Inc.
Address Shields Bldg., Russell, Kansas

STATE OF KANSAS, COUNTY OF RUSSELL, ss. contractor
R. J. Shields (employee of owner) or (owner or operator) of the above-described well, being first duly sworn on oath, says: That I have knowledge of the facts, statements, and matters herein contained and the log of the above-described well as filed and that the same are true and correct. So help me God.

(Signature) [Signature]
Shields Bldg., Russell, Kansas (Address)

Subscribed and sworn to before me this 19th day of January, 1973

[Signature]
Notary Public.





Shields


15-195-20239-00-00

Russell, Kansas

WELL LOG

Operator: Black Petroleum Co.
 Well: Babb #1
 Commenced: December 22, 1972
 Completed: January 8, 1973
 Contractor: Shields Drilling Co., Inc.

Well Description: C W/2 NW/4 NE/4
 Sec. 9-12S-22W
 Trego Co., Kansas

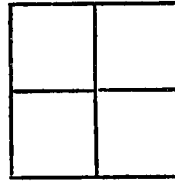

Elevation: 2,378' RB
 Treatment:
 Production: D & A
 Tops: -----

CASING RECORD

Size	Run	Pulled
8 5/8"	243'	Cmtd. w/150 sax.

..... Figures Indicate Bottom of Formations

Top soil & clay	50'
Clay & sand	135'
Shale	1,310'
Sand	1,550'
Redbed	1,830'
Anhydrite	1,866'
Shale & shells	2,400'
Shale & lime	3,570'
Lime	4,057'
Lime & shale	4,093'
Lime	4,108' RTD

RECEIVED
 STATE CORPORATION COMMISSION
 01-23-1973
 JAN 23 1973
 CONSERVATION DIVISION
 Wichita, Kansas

Notes