


STATE OF KANSAS
STATE CORPORATION COMMISSION

WELL PLUGGING RECORD

Give All Information Completely
Make Required Affidavit
Mail or Deliver Report to:
Conservation Division
State Corporation Commission
800 Bittling Building
Wichita, Kansas

NORTH

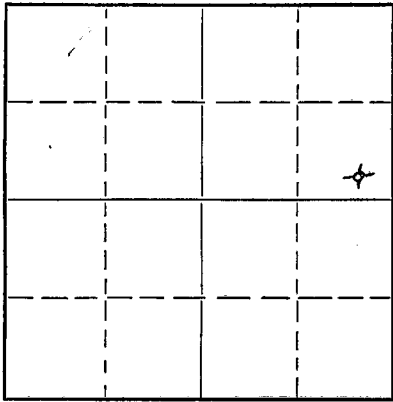

Locate well correctly on above
Section Flat

Graham County, Sec. 26 Twp. 10S. Rge. 21 (E) W. (W)
Location as "NE/CNW 1/4 SW 1/4" or footage from lines N SE 1/4 SE 1/4 NE 1/4
Lease Owner Anderson-Prichard Oil Corp.
Lease Name Barber "A" Well No. 1
Office Address Liberty Bank Building, Oklahoma City, Oklahoma
Character of Well (completed as Oil, Gas or Dry Hole) Dry Hole
Date well completed July 27 19.52
Application for plugging filed July 27 19.52
Application for plugging approved July 27 19.52
Plugging commenced July 27 19.52
Plugging completed July 27 19.52
Reason for abandonment of well or producing formation Dry Hole

If a producing well is abandoned, date of last production 19.
Was permission obtained from the Conservation Division or its agents before plugging was commenced? Yes

Name of Conservation Agent who supervised plugging of this well Eldon R. Petty
Producing formation Depth to top Bottom Total Depth of Well Feet
Show depth and thickness of all water, oil and gas formations.

OIL, GAS OR WATER RECORDS

CASING RECORD

Formation	Content	From	To	Size	Put In	Pulled Out
		0	194'	8 5/8"	194'	None

Describe in detail the manner in which the well was plugged, indicating where the mud fluid was placed and the method or methods used in introducing it into the hole. If cement or other plugs were used, state the character of same and depth placed, from feet to feet for each plug set.

3805' - 191 1/2' - Heavy Rotary Mud
191 1/2' - 190' - Wooden Plug
190' - 144' - 15 sacks cement
144' - 41 1/2' - Heavy Rotary Mud
41 1/2' - 40' - Wooden Plug
40' - 6' - 10 Sacks cement
6' - Surface - Cellar

7-31-1952
JUL 31 1952
CONSERVATION DIVISION
Wichita, Kansas

(If additional description is necessary, use BACK of this sheet)


Name of Plugging Contractor Glenn W. Peel
Address P. O. Box 359, Hoisington, Kansas

STATE OF Kansas, COUNTY OF Barton, ss.
Glenn W. Peel (employee of owner) or (owner or operator) of the above-described well,

being first duly sworn on oath, says: That I have knowledge of the facts, statements, and matters herein contained and the log of the above-described well as filed and that the same are true and correct. So help me God.

(Signature) BY: Glenn W. Peel
P. O. BOX 359
HOISINGTON, KANSAS (Address)

SUBSCRIBED AND SWORN to before me this 29th day of July, 1952

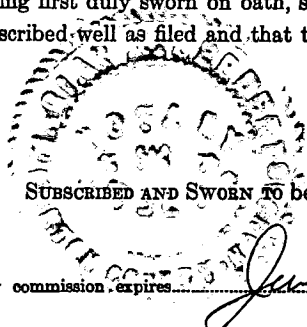

Marion M. Herbst
Notary Public.

PLUGGING
FILE SEC 26 T 10 R 21
BOOK PAGE 34 OF 8

DRILLER'S LOG

Company: Anderson-Prichard Oil Corp.

SE/4 SE/4 NE/4
Sec. 26, Twp. 10S, Rge. 21W

Farm: Barber "A" Well No: 1
Total Depth: 3805'

County: Graham,
Kansas

Comm: 7-15-52 Comp: 7-27-52

Contractor: Glenn W. Peel

Elevation:

Casing:
8 5/8" 198' cem.

Production: Dry

Figures below indicate bottom of formations

Surface Soil	0 -	70
Shale & Shells		198
Shale		870
Sand & Shale		1340
Shale & Red Bed		1620
Anhydrite		1650
Shale		1740
Shale & Shells		1960
Shale & Lime		2100
Lime		2715
Lime & Shale		2830
Lime		3360
Lime & Shale		3430
Lime		3725
Conglomerate		3739
Lime Chert		3785
Conglomerate & Lime		3805
Total Depth		3805

This is to certify that the above information is, to the best of our knowledge true and correct.

GLENN W. PEEL

BY: W. Herbert

SUBSCRIBED AND SWORN to before me this 29th day of July, 1952.

My commission expires June 11, 1955

Manan M. Herbert
Notary Public

