

15-065-30054-00-00

STATE OF KANSAS  
STATE CORPORATION COMMISSION

Form CP-4


Give All Information Completely  
Make Required Affidavit  
Mail or Deliver Report to:  
Conservation Division  
State Corporation Commission  
211 No. Broadway  
Wichita, Kansas

WELL PLUGGING RECORD

GRAHAM County. Sec. 26 Twp. 10S Rge. 21W (X) X (W)

Location as "NE/CNW/SW" or footage from lines NW SW SE  
Lease Owner PETROLEUM, INC.  
Lease Name BARBER Well No. 1  
Office Address ROUTE #2, GREAT BEND, KANSAS  
Character of Well (completed as Oil, Gas or Dry Hole) DRY HOLE  
Date well completed JULY 3, 19 65  
Application for plugging filed JULY 3, 19 65  
Application for plugging approved JULY 3, 19 65  
Plugging commenced JULY 3, 19 65  
Plugging completed JULY 3, 19 65  
Reason for abandonment of well or producing formation NO PRODUCIBLE ZONES

NORTH

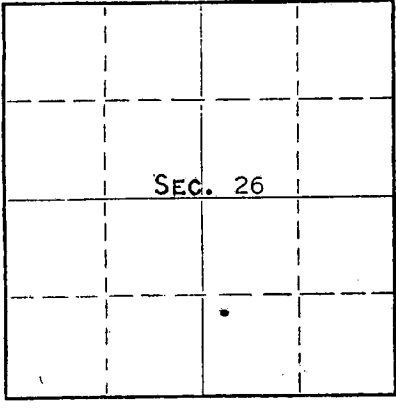

Locate well correctly on above  
Section Plat

If a producing well is abandoned, date of last production NONE 19  
Was permission obtained from the Conservation Division or its agents before plugging was commenced? YES

Name of Conservation Agent who supervised plugging of this well W. L. NICHOLS  
Producing formation - Depth to top - Bottom - Total Depth of Well 3415 Feet  
Show depth and thickness of all water, oil and gas formations.

OIL, GAS OR WATER RECORDS

CASING RECORD

FORMATION	CONTENT	FROM	TO	SIZE	PUT IN	PULLED OUT
				8-5/8"	217'	NONE

Describe in detail the manner in which the well was plugged, indicating where the mud fluid was placed and the method or methods used in introducing it into the hole. If cement or other plugs were used, state the character of same and depth placed, from feet to feet for each plug set.

MUDDED UP WITH HEAVY MUD TO 545', FOLLOWED BY WOODEN PLUG. PLACED 25 SACKS CEMENT THROUGH DRILL PIPE ONTO PLUG. MUDDED UP WITH HEAVY MUD TO 210', FOLLOWED BY WOODEN PLUG. PLACED 20 SACKS CEMENT THROUGH DRILL PIPE ONTO PLUG. MUDDED UP WITH HEAVY MUD TO 35', FOLLOWED BY 1/2 SACK HULLS, WOODEN PLUG AND 10 SACKS CEMENT TO BASE OF WELL CELLAR.

RECEIVED  
STATE CORPORATION COMMISSION  
7-15-1965  
JUL 15 1965  
CONSERVATION DIVISION  
Wichita, Kansas

(If additional description is necessary, use BACK of this sheet)

Name of Plugging Contractor GARVEY DRILLING COMPANY  
Address ROUTE #2, GREAT BEND, KANSAS

STATE OF KANSAS, COUNTY OF BARTON, ss.  
MONTE CHADD (employee of owner) or (owner or operator) of the above-described well, being first duly sworn on oath, says: That I have knowledge of the facts, statements, and matters herein contained and the log of the above-described well as filed and that the same are true and correct. So help me God.

(Signature) Monte Chadd  
MONTE CHADD, DIST. PROD. SUPT.  
ROUTE #2, GREAT BEND, KANSAS  
(Address)

SUBSCRIBED AND SWORN TO before me this 14 day of JULY, 19 65

Arthur J. Wiles  
Notary Public.

My commission expires APRIL 14, 1967

WELL LOG 15-065-30054-00-00

COMPANY Petroleum, Inc.

SEC. 26 T. 10S R. 21W

FARM Barber NO. 1


LOC. NW SW SE

TOTAL DEPTH 3415'

COUNTY Graham

COMM. 6-27-65 COMP. 7-3-65

CONTRACTOR Garvey Drilling Company

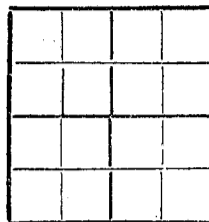

CASING 8 5/8" @ 217' w/175 sx

ELEVATION 2149' DF

PRODUCTION D & A

FIGURES INDICATE BOTTOM OF FORMATIONS

- 217' Shale and Sand
- 770' Shale
- 860' Sand
- 1350' Shale and Shells
- 1390' Anhydrite
- 1555' Shale and Shells
- 1623' Shale
- 1669' Anhydrite
- 1835' Shale and Shells
- 2045' Shale
- 2315' Lime and Shale
- 2545' Shale and Lime
- 2705' Lime and Shale
- 2990' Shale and Lime
- 3115' Lime and Shale
- 3345' Shale and Lime
- 3415' Lime and Shale
- 3415' RTD

**RECEIVED**  
 STATE CORPORATION COMMISSION  
 7-15-1965  
 JUL 15 1965  
 CONSERVATION DIVISION  
 Wichita, Kansas

State of Kansas }  
 County of Barton } SS

I, Sam N. Stephens of Garvey Drilling Company

upon oath state the above and foregoing is a true and correct copy of the log of the Barber #1 well.

*Sam N. Stephens*

Subscribed and sworn to before me this 13th day of July 1965

My Commission Expires: April 14th, 1967

*Arthur J. Miles*  
 NOTARY PUBLIC