


15-065-02607-00-00

STATE OF KANSAS  
STATE CORPORATION COMMISSION

Give All Information Completely  
Make Required Affidavit  
Mail or Deliver Report to:  
Conservation Division  
State Corporation Commission  
800 Biting Building  
Wichita, Kansas

WELL PLUGGING RECORD

NORTH

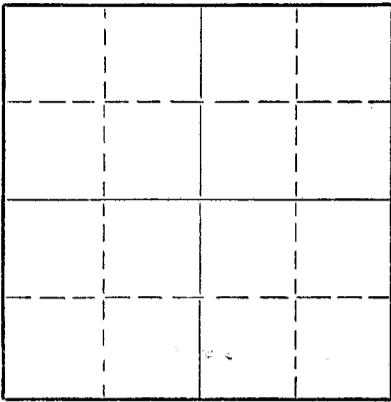

Locate well correctly on above  
Section Plat

Graham County, Sec. 26 Twp. 10S Rge. (E) 21(W)  
Location as "NE/CNW/SW" or footage from lines C E/2 NE SE  
Lease Owner Jones, Shelburne & Farmer, Inc.  
Lease Name Barber Well No. 1  
Office Address Russell, Kansas  
Character of Well (completed as Oil, Gas or Dry Hole) Dry  
Date well completed 11-4 19 52  
Application for plugging filed 11-4 19 52  
Application for plugging approved 11-4 19 52  
Plugging commenced 11-4 19 52  
Plugging completed 11-4 19 52  
Reason for abandonment of well or producing formation Dry

If a producing well is abandoned, date of last production Never produced 19  
Was permission obtained from the Conservation Division or its agents before plugging was commenced? yes

Name of Conservation Agent who supervised plugging of this well Elden Petty  
Producing formation \_\_\_\_\_ Depth to top \_\_\_\_\_ Bottom \_\_\_\_\_ Total Depth of Well 3807 Feet  
Show depth and thickness of all water, oil and gas formations.


OIL, GAS OR WATER RECORDS

CASING RECORD

FORMATION	CONTENT	FROM	TO	SIZE	PUT IN	PULLED OUT
				8 5/8	170'	None

Describe in detail the manner in which the well was plugged, indicating where the mud fluid was placed and the method or methods used in introducing it into the hole. If cement or other plugs were used, state the character of same and depth placed, from \_\_\_\_\_ feet to \_\_\_\_\_ feet for each plug set.

1. Filled hole with heavy mud
2. Pushed plug to 160'
3. Dumped 1/2 sack hulls on top of plug
4. Mixed 15 sacks cement and dumped on top of hulls.
5. Filled hole to top
6. Pushed plug to 40'
7. Dumped in 1/2 sack hulls.
8. Mixed 10 sacks cement and filled hole to top with same.

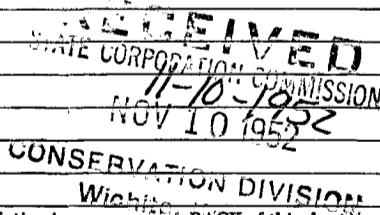


Name of Plugging Contractor Jones, Shelburne & Farmer, Inc.  
Address Russell, Kansas

STATE OF \_\_\_\_\_, COUNTY OF \_\_\_\_\_, ss. \_\_\_\_\_ (employee of owner) or (owner or operator) of the above-described well, being first duly sworn on oath, says: That I have knowledge of the facts, statements, and matters herein contained and the log of the above-described well as filed and that the same are true and correct. So help me God.

(Signature) John O. Farmer  
(Address) \_\_\_\_\_



Subscribed and Sworn to before me this 7th day of November 1952  
Bonnie Berryhill Notary Public.

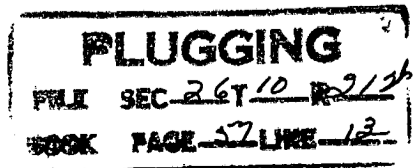


OPERATOR Jones, Shelburne & Farmer, Inc.

15-065-02607-00-00

## FORMATION RECORD

Give detailed description and thickness of all formations drilled through, contents of sand, whether dry, water, oil or gas.

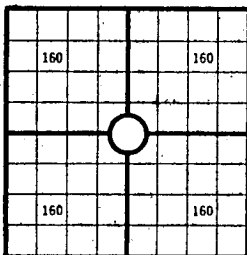ADDRESS Russell, Kansas640 Acres  
N

Locate well correctly

COUNTY Graham SEC. 26 TWP. 10S RGE. 21W  
 COMPANY OPERATING Jones, Shelburne & Farmer, Inc.  
 OFFICE ADDRESS Russell, Kansas  
 FARM NAME Barber WELL NO. 1  
 DRILLING STARTED 10-23 19 52 DRILLING FINISHED 11-4 19 52  
 DATE OF FIRST PRODUCTION \_\_\_\_\_ COMPLETED \_\_\_\_\_  
 WELL LOCATED C E/2 NE 1/4 SE 1/4 North of South  
 Line and \_\_\_\_\_ ft. East of West Line of Quarter Section  
 Elevation (Relative to sea level) DERRICK FLOOR 2156 ROUND \_\_\_\_\_  
 CHARACTER OF WELL (Oil, gas or dryhole) Dry

## OIL OR GAS SANDS OR ZONES

Name	From	To	Name	From	To
1			4		
2			5		
3			6		

## Perforating Record If Any

## Shot Record

Formation	From	To	No. of Shots	Formation	From	To	Size of Shot

## CASING RECORD

Amount Set						Amount Pulled		Packer Record	
Size	Wt.	Thds.	Make	Ft.	In.	Ft.	In.	Size	Length
8 5/8	24	8	LW	170				None	

Liner Record: Amount \_\_\_\_\_ Kind \_\_\_\_\_ Top \_\_\_\_\_ Bottom \_\_\_\_\_

## CEMENTING AND MUDDING

Size	Amount Set		Sacks Cement	Chemical		Method of Cementing	Amount	Mudding Method	Results (See Note)
	Ft.	In.		Gal.	Make				
8 5/8	170		100						

Note: What method was used to protect sands if outer strings were pulled? \_\_\_\_\_

NOTE: Were bottom hole plugs used? \_\_\_\_\_ If so, state kind, depth set and results obtained \_\_\_\_\_

## TOOLS USED

Rotary Tools were used from \_\_\_\_\_ feet to \_\_\_\_\_ Cable tools were used from \_\_\_\_\_ feet to \_\_\_\_\_

\_\_\_\_\_ feet, and from \_\_\_\_\_ feet to \_\_\_\_\_ feet, and from \_\_\_\_\_ feet to \_\_\_\_\_

Type Rig \_\_\_\_\_

## INITIAL PRODUCTION TEST

Describe initial test: whether by flow through tubing or casing or by pumping \_\_\_\_\_

Amount of Oil Production \_\_\_\_\_ bbls. Size of choke, if any \_\_\_\_\_ Length of test \_\_\_\_\_ Water \_\_\_\_\_

Production \_\_\_\_\_ bbls. Gravity of oil \_\_\_\_\_ Type of Pump if pump is used, describe \_\_\_\_\_

Formation	Top	Bottom	Formation	Top	Bottom
Shale	0	150			
Shale & Shells	150	465			
Shale Shells Sand	465	1420			
Shale & Shells	1420	1630			
Anhydrite	1630	1675			
Shale & Shells	1675	2240			
Lime & Shale	2240	3380			
Lime	3380	3595			
Lime & Shale	3595	3807			

TOPS:

Elevation 2158 R. B.  
 Heebner 3417  
 Toronto 3445  
 Lansing 3460  
 Base of K. C. 3678  
 Cherty Conglomerate 3770  
 Total Depth 3807  
 D & A

PLUGGING

FILE SEC 26 TWP 10S RGE 21W

BOOK PAGE 27 LINE 13

11-10-1952

I, the undersigned, being first duly sworn upon oath, state that this well record is true, correct and complete according to the records of this office and to the best of my knowledge and belief.

*John D. Farmer*  
 Vice-President

Name and title of representative of company

Subscribed and sworn to before me this 7th day of November 1952My Commission expires April 23, 1956 *Bonnie Berryhill* Notary Public.

FARM NAME Barber WELL NO. 1 COUNTY Graham SEC. 26 TWP. 10S RGE. 21W  
 15-065-02607-00-00