


STATE OF KANSAS
STATE CORPORATION COMMISSION

WELL PLUGGING RECORD

Give All Information Completely
Make Required Affidavit
Mail or Deliver Report to:
Conservation Division
State Corporation Commission
800 Bitting Building
Wichita, Kansas

Graham County, Sec. 26 Twp. 10S Rge. 21 (E) W (W)

Location as "NE/CNW/SW" or footage from lines SE NE NE
Lease Owner Anderson-Frichard Oil Corporation
Lease Name Barber "A" Well No. 2
Office Address Liberty Bank Building
Character of Well (completed as Oil, Gas or Dry Hole) Dry Hole
Date well completed May 19, 1953
Application for plugging filed May 19, 1953
Application for plugging approved May 19, 1953
Plugging commenced May 19, 1953
Plugging completed May 19, 1953
Reason for abandonment of well or producing formation Dry hole

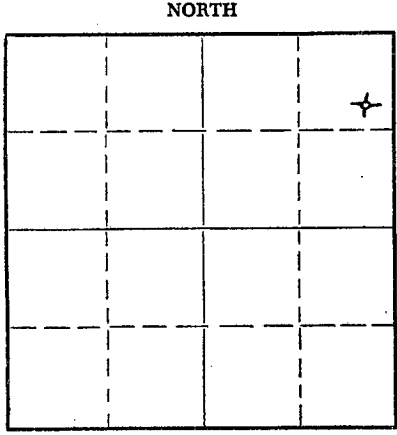

Locate well correctly on above Section Plat

If a producing well is abandoned, date of last production _____ 19____
Was permission obtained from the Conservation Division or its agents before plugging was commenced? Yes

Name of Conservation Agent who supervised plugging of this well Eldon Petty
Producing formation _____ Depth to top _____ Bottom _____ Total Depth of Well _____ Feet
Show depth and thickness of all water, oil and gas formations.

OIL, GAS OR WATER RECORDS

CASING RECORD

FORMATION	CONTENT	FROM	TO	SIZE	PUT IN	PULLED OUT
		0	205	8 5/8	205'	None

Describe in detail the manner in which the well was plugged, indicating where the mud fluid was placed and the method or methods used in introducing it into the hole. If cement or other plugs were used, state the character of same and depth placed, from _____ feet to _____ feet for each plug set.


From 3784' to 201 1/2' - Heavy rotary mud
201 1/2' to 200' - Wooden plug
200' to 154' - 15 sks cement & 1 sk. hulls
154' to 41 1/2' - Heavy rotary mud
41 1/2' to 40' - Wooden Plug
40' to 6' - 10 sks cement
6' to Surface - Cellar

(If additional description is necessary, use BACK of this sheet)

Name of Plugging Contractor Glenn W. Peel
Address P.O. Box 359, Hoisington, Kansas

STATE OF Kansas, COUNTY OF Barton, ss.
Glenn W. Peel (employee of owner) or (~~holder of interest~~) of the above-described well, being first duly sworn on oath, says: That I have knowledge of the facts, statements, and matters herein contained and the log of the above-described well as filed and that the same are true and correct. So help me God. GLENN W. PEEL

(Signature) _____ BY: Manion M. Harber
P.O. Box 359, Hoisington, Kansas
(Address)

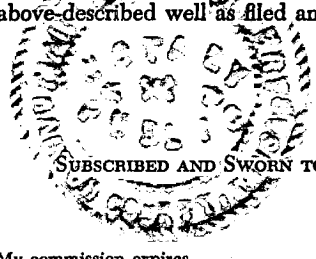

SUBSCRIBED AND SWORN TO before me this 25th day of May, 1953
My commission expires June 4, 1955
Notary Public.

24-7368-5 3-53-20M
JUN 5 1953
Wichita, Kan

PLUGGING
FILE SEC 26 T 10 R 21 W
BOOK PAGE 102 LINE 25

DRILLER'S LOG

Company: Anderson-Pfichard Oil Corp.

SE NE NE
Sec. 26, Twp. 10 S, Rge. 21 W,

Farm Name: Barber "A" Well No. 2

Total Depth: 3784'

County: Graham,
Kansas

Comm: 5-9-53 Comp: 5-19-53

Contractor: Glenn W. Peel

Elevation:

Casing: 8 5/8" 205' cem.

Production: Dry

Figures below indicate bottom of formation:

Surface clay and Shale	0	205
Shale		1650
Anhydrite		1690
Shale		1730
Lime		2070
Shale and Lime		2230
Lime		3784
Total Depth		3784

This is to certify that the above information is to the best of our knowledge, true and correct.

GLENN W. PEEL

BY: *Glenn W. Peel*

SUBSCRIBED AND SWORN to before me this 25th day of May, 1953.

My Commission expires June 4, 1955 *Marion M. Herbert*
Notary Public

5-29-1953

PLUGGING
FILE SEC 26 T 10 R 21 W
BOOK PAGE 102 LINE 25