


STATE OF KANSAS  
STATE CORPORATION COMMISSION

WELL PLUGGING RECORD

Give All Information Completely  
Affidavit Required  
Mail or Deliver Report to:  
Conservation Division  
State Corporation Commission  
800 Bitting Building  
Wichita, Kansas

Graham County. Sec. 26 Twp. 10 Rge. 21 (E) W (W)  
Location as "NE/CNWxSWx" or footage from lines SW SE SE  
Lease Owner C-G DRILLING CO. & D. G. HANSEN  
Lease Name BARBER "A" Well No. 1  
Office Address 107 Rule Bldg., Wichita, Kansas  
Character of Well (completed as Oil, Gas or Dry Hole) Dry hole  
Date well completed September 12 19 55  
Application for plugging filed September 12 19 55  
Application for plugging approved September 12 19 55  
Plugging commenced September 13 19 55  
Plugging completed September 13 19 55  
Reason for abandonment of well or producing formation Too low structurally

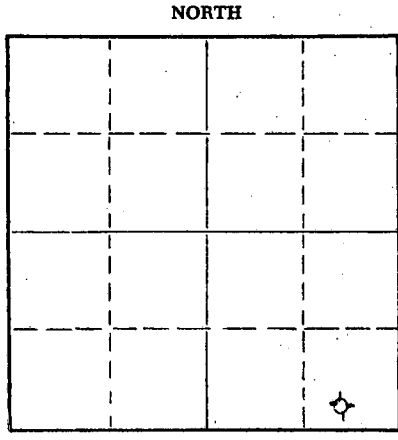

Locate well correctly on above Section Plat

If a producing well is abandoned, date of last production \_\_\_\_\_ 19 \_\_\_\_  
Was permission obtained from the Conservation Division or its agents before plugging was commenced? Yes

Name of Conservation Agent who supervised plugging of this well Eldon Petty, Hays, Kansas  
Producing formation \_\_\_\_\_ Depth to top \_\_\_\_\_ Bottom \_\_\_\_\_ Total Depth of Well \_\_\_\_\_ Feet  
Show depth and thickness of all water, oil and gas formations.

OIL, GAS OR WATER RECORDS

CASING RECORD

FORMATION	CONTENT	FROM	TO	SIZE	PUT IN	PULLED OUT
				8-5/8	184'	none

Describe in detail the manner in which the well was plugged, indicating where the mud fluid was placed and the method or methods used in introducing it into the hole. If cement or other plugs were used, state the character of same and depth placed, from \_\_\_\_\_ feet to \_\_\_\_\_ feet for each plug set.

Filled hole with heavy mud to 179'. Set plug  
Put in 1/2 sack hulls and 15 sacks of cement.  
Filled with heavy mud up to 40'. Set plug.  
Filled to top with 1/2 sack hulls and 10 sacks  
cement.

(If additional description is necessary, use BACK of this sheet)

Name of Plugging Contractor C-G DRILLING CO.  
Address 107 Rule Bldg., Wichita, Kansas

STATE OF KANSAS COUNTY OF SEDGWICK, ss.  
G. F. GALLOWAY (employee of owner) or (owner or operator) of the above-described well, being first duly sworn on oath, says: That I have knowledge of the facts, statements, and matters herein contained and the log of the above-described well as filed and that the same are true and correct. So help me God.

(Signature) G. F. Galloway  
107 Rule Bldg., Wichita, Kansas  
(Address)

SUBSCRIBED AND SWORN TO before me this 21st day of September, 1955

My commission expires May 20, 1959

Wicky Jacobs  
Notary Public.



**PLUGGING**  
FILE SEC 26 T 10 R 216  
BOOK PAGE 2 LINE 16

STATE CORPORATION COMMISSION  
SEP 22 1955  
CONSERVATION DIVISION  
Wichita, Kansas

BARBER "A" - 1  
Graham County, Kansas

Operator: C-G Drilling Company  
107 Rule Building  
Wichita 2, Kansas

Contractor: Lohmann-Johnson Drilling Co., Inc.  
320 Indiana Bank Building  
Evansville, Indiana

Casing: Ran 9 Jts. 8-5/8" Surface Pipe set @ 184' w/150 Sacks

Started: September 4, 1955  
Completed: September 13, 1955

L O G

<u>FROM</u>	<u>TO</u>	<u>FORMATION</u>
0	185	Shale
185	1350	Shale, Shells & Sand
1350	1642	Red Bed
1642	1665	Anhydrite
1665	2015	Lime & Shale
2015	2265	Shale & Shells
2265	2455	Lime & Shale
2455	2550	Shale & Lime
2550	2910	Lime & Shale
2910	3075	Shale & Lime
3075	3315	Lime & Shale
3315	3374	Shale & Lime
3374	3440	Lime & Shale
3440	3727	Lime
3727	3792	Lime & Shale
3792		TOTAL DEPTH

Dry and Abandoned - Plugged September 13, 1955

The undersigned, Lohmann-Johnson Drilling Company, Inc., hereby certifies that the above Log is a true and correct Log of the formations encountered in drilling the above Well as reflected by the Daily Drilling Reports.

LOHMANN-JOHNSON DRILLING CO., INC.

By *Thelma V. Shields*

Subscribed and sworn to  
before me this 19th day of September, 1955

*Virginia Brubaker*  
Notary Public

My Commission expires: 8/28/59

SEP 19 1955

9-22-1955  
RECORDED  
INDEXED

**PLUGGING**  
FILE SEC 26 T10 R214  
BOOK PAGE 2 LINE 16