

15-065-00697-00-00

STATE OF KANSAS
STATE CORPORATION COMMISSION


Give All Information Completely
Make Required Affidavit
Mail or Deliver Report to:
Conservation Division
State Corporation Commission
212 North Market, Insurance Bldg.
Wichita, Kansas

WELL PLUGGING RECORD

Graham County, Sec. 26 Twp. 10 Rge. 21 (X) W (W)

Location as "NE/CNW&SW&W" or footage from lines NW NW SE
Lease Owner C-G Drilling Company
Lease Name Barber Well No. B2
Office Address 107 Rule Building Wichita, Kansas
Character of Well (completed as Oil, Gas or Dry Hole) oil
Date well completed April 28 19 61
Application for plugging filed April 28 19 61
Application for plugging approved April 28 19 61
Plugging commenced April 28 19 61
Plugging completed May 3 19 61
Reason for abandonment of well or producing formation oil reservoir depleted.

NORTH

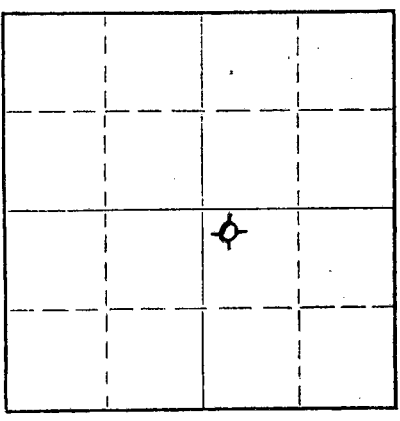

Locate well correctly on above Section Plat

If a producing well is abandoned, date of last production November 1958
Was permission obtained from the Conservation Division or its agents before plugging was commenced? yes

Name of Conservation Agent who supervised plugging of this well A. D. Fabricius, Hill City.
Producing formation _____ Depth to top _____ Bottom _____ Total Depth of Well 3769 1/2 Feet
Show depth and thickness of all water, oil and gas formations.

OIL, GAS OR WATER RECORDS

CASING RECORD

FORMATION	CONTENT	FROM	TO	SIZE	PUT IN	PULLED OUT
				8 5/8	178	none
				5 1/2	3768	1141.74'

Describe in detail the manner in which the well was plugged, indicating where the mud fluid was placed and the method or methods used in introducing it into the hole. If cement or other plugs were used, state the character of same and depth placed, from _____ feet to _____ feet for each plug set.

Plugged back to 3705' with 14' of sand & 5 sks cement.
10' rock bridge
Filled hole to 30' with 25 sacks of cement.
Capped with 10 sacks of cement.

RECEIVED
STATE CORPORATION COMMISSION
5-26-1961
MAY 26 1961


CONSERVATION DIVISION
Wichita, Kansas

(If additional description is necessary, use BACK of this sheet)
Name of Plugging Contractor PIPE PULLERS, INC.
Address Ellinwood, Kansas

STATE OF KANSAS, COUNTY OF SEDGWICK, ss.
G. F. Galloway (employee of owner) or (owner or operator) of the above-described well, being first duly sworn on oath, says: That I have knowledge of the facts, statements, and matters herein contained and the log of the above-described well as filed and that the same are true and correct. So help me God.

(Signature) G. F. Galloway
107 Rule Building
(Address)

SUBSCRIBED AND SWORN to before me this 25th day of May, 1961
My commission expires May 20, 1963

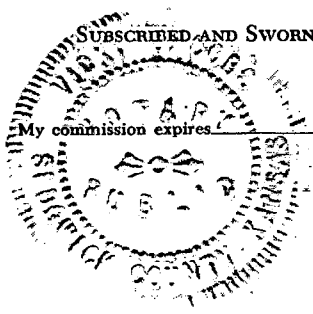

Vicky Jacobs
Notary Public.

W E L L L O G

OPERATOR C-G Drilling SEC. 26-10-21W
 WELL NAME Barber "B" #2 LOC. NW NW SE
 TOTAL DEPTH 3773' COUNTY Graham
 COMM. October 11, 1955 Drilling COMP. October 24, 1955 STATE Kansas
 RIG NO. 2 ELEVATION 2173 R.B.
 CASING: Left in hole 178' 8-5/8" OD Surface PRODUCTION: D & A
 Casing. And 5-1/2" OD Casing @2626.26'

All measurements taken from the top of rotary bushing.

FROM	TO	FORMATION	DEVIATION FROM VERTICAL	REMARKS:
0	90	Sand-Shale		
90	175	Shale		
175	780	Shale, Shells-Red Bed		
780	890	Sand-Shale		
890	1000	Shale-Shells		
1000	1375	Shale-Sand		
1375	1637	Red Bed-Shale		
1637	1693	Anhydrite		
1693	1955	Shale-Shells		
1955	2100	Shale		
2100	2370	Shale-Lime		
2370	2485	Lime-Shale		
2485	2580	Lime	0° - 2500'	DST 3522-3538
2580	2755	Lime-Shale	0° - 2750'	
2755	2805	Shale-Lime	0° - 3000'	
2805	3423	Lime-Shale	0° - 3250'	
3423	3773	Lime	0° - 3500'	DST 3768-3773
			0° - 3750'	

RECEIVED
 STATE CORPORATION COMMISSION
 5-26-1961
 MAY 26 1961
 CONSERVATION DIVISION
 Wichita, Kansas

STATE OF KANSAS }
 COUNTY OF SEDGWICK } SS.

The undersigned hereby certifies that to the best of his knowledge and belief, the above facts are true and correct.

C-G DRILLING CO.
 By G. F. Galloway
 G. F. Galloway

SUBSCRIBED AND SWORN TO, BEFORE ME, THIS 11th day of May, 1961.
Vicky Jacobs
 Vicky Jacobs - Notary public

