15-065-02294-0000

STATE OF KANSAS
STATE CORPORATION COMMISSION


Give All Information Completely
Make Required Affidavit
Mail or Deliver Report to:
Conservation Division
State Corporation Commission
800 Bitting Building
Wichita, Kansas

WELL PLUGGING RECORD

23W AND KCC

Graham County. Sec. 12 Twp. 10S Rge. 21W (E) W (W)

NORTH

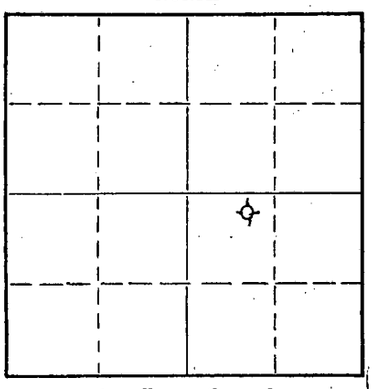

Locate well correctly on above Section Plat

Location as "NE/CNW¼SW¼" or footage from lines NE NW SE
Lease Owner D. G. Hansen
Lease Name Fritts Well No. 1
Office Address Logan, Kansas
Character of Well (completed as Oil, Gas or Dry Hole) dry hole
Date well completed September 1, 1955
Application for plugging filed September 1, 1955
Application for plugging approved September 1, 1955
Plugging commenced September 1, 1955
Plugging completed September 1, 1955
Reason for abandonment of well or producing formation Too low structurally

If a producing well is abandoned, date of last production 19
Was permission obtained from the Conservation Division or its agents before plugging was commenced? Yes

Name of Conservation Agent who supervised plugging of this well Eldon Petty, Hays, Kansas
Producing formation Depth to top Bottom Total Depth of Well Feet
Show depth and thickness of all water, oil and gas formations.

OIL, GAS OR WATER RECORDS — CASING RECORD

FORMATION	CONTENT	FROM	TO	SIZE	PUT IN	PULLED OUT
				8-5/8"	160.51'	none

Describe in detail the manner in which the well was plugged, indicating where the mud fluid was placed and the method or methods used in introducing it into the hole. If cement or other plugs were used, state the character of same and depth placed, from feet to feet for each plug set.

Filled hole with heavy mud to 155'. Set plug. Put in 1/2 sack hulls and 15 sacks cement. Set plug, @ 40'. Put in 1/2 sack hulls and 10 sacks cement to top.

RECEIVED
STATE CORPORATION COMMISSION
SEP - 9 1955
09-07-55
CONSERVATION DIVISION

(If additional description is necessary, use BACK of this sheet)

Name of Plugging Contractor C-G Drilling Co.
Address 107 Rule Building, Wichita, Kansas

STATE OF KANSAS, COUNTY OF SEDGWICK, ss.

Jay H. Galloway (employee of owner) or ~~(owner or operator)~~ of the above-described well, being first duly sworn on oath, says: That I have knowledge of the facts, statements, and matters herein contained and the log of the above-described well as filed and that the same are true and correct. So help me God.

(Signature) Jay H. Galloway

107 Rule Bldg., Wichita, Kansas
(Address)

SUBSCRIBED AND SWORN TO before me this 6th day of September, 1955

Vicky Jacobs
Notary Public.

My commission expires May 20, 1959

VICKY JACOBS NOTARY PUBLIC SEDGWICK COUNTY, KANSAS

PLUGGING
FILE SEC 12 T 10 R 22W
BOOK PAGE 147 LINE 28

5-44M

15-065-02294-0000

CONTRACTOR'S WELL LOG

OPERATOR D. G. HANSEN WELL NAME FRITTS #1

WELL LOCATION NE NW SE Sec. 12-10S-23W

POOL NAME COUNTY GRAHAM STATE KANSAS

COMMENCEMENT DATE AUGUST 20, 1955 COMPLETION DATE SEPTEMBER 1, 1955

LOG OF WELL

Elevation 2412 rotary bushing.
All measurements from the top of rotary bushing.

FROM	TO	FORMATION	DEVIATION FROM VERTICAL	REMARKS:
0	160	Shale		
160	945	Shale		
945	1010	Sand		
1010	1160	Sand-Shale		
1160	1460	Sandy-Shale		
1460	1710	Sand		
1710	1950	Red Bed		
1950	1961	Red Bed		
1961	2000	Anhydrite		
2000	2175	Shale-Shells		
2175	2375	Lime-Shale		
2375	2535	Lime-Shale	0°- 2500'	
2535	2735	Lime-Shale		
2735	2865	Lime-Shale	0°- 2750'	
2865	2965	Lime-Shale		
2965	3105	Lime-Shale	0°- 3000'	
3105	3175	Lime-Shale		
3175	3300	Lime-Shale	0°- 3250'	
3300	3435	Lime-Shale		3425' Topeka
3435	3520	Lime-Shale	0°- 3500'	
3520	3580	Lime-Shale		
3580	3655	Lime-Shale		3651' Heebner
3655	3705	Lime-Shale		3670' Toronto
3705	3730	Lime-Shale		1. DST 3722-30'
3730	3750	Lime-Shale	0°-3750'	3686' Lansing
3750	3795	Lime-Shale		
3795	3826	Lime-Shale		
3826	3835	Lime-Shale		2. DST 3812-26'
3835	3856	Lime-Shale		3. DST 3844-56'
3856	3875	Lime-Shale		
3875	3885	Lime-Shale		4. DST 3855-75'
3885	3935	Lime-Shale		3911' B. Kansas City
3935	3979	Lime-Shale		
3979	4025	Lime-Shale	0°-4000'	
4025	4065	Lime		
4065	4096	Lime-Shale		4090' Conglomerate
4096	4105	Lime-Shale		5. DST 4080-96'
4105	4141	Lime-Shale		
4141	4175	Cherty Lime		4152' Simpson 4160' Arbuckle

CASING LEFT IN HOLE AFTER COMPLETION

Set 160.51' of 8-5/8" OD Surface Casing

PLUGGING
FILE SEC 12 T 10 R 23W
BOOK PAGE 147 LINE 28

STATE OF KANSAS, COUNTY OF SEDGWICK) ss.

The undersigned certifies that to the best of his knowledge and belief, the above facts are true and correct.

Subscribed and sworn to before me this 6th day of September, 1955.

Vicky Jacobs, Notary Public

My Commission Expires 5/29/59

C-G DRILLING CO.
By G. F. Galloway
G. F. Galloway