


15-065-00854-0000

Give All Information Completely
Make Required Affidavit
Mail or Deliver Report to:
Conservation Division
State Corporation Commission
211 No. Broadway
Wichita, Kansas

WELL PLUGGING RECORD

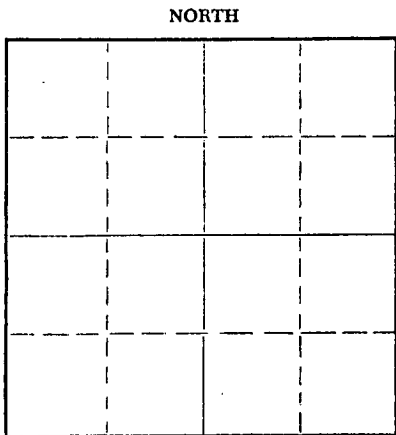

Locate well correctly on above Section Plat

Graham County. Sec. 15 Twp. 10 Rge. 23 (E) (W)
Location as "NE/CNW/SW" or footage from lines SW SW NW
Lease Owner Trans Era Petroleum, Inc.
Lease Name LAW Well No. 1
Office Address 420 W. Douglas Ave., Wichita, Kansas
Character of Well (completed as Oil, Gas or Dry Hole) Dry Hole
Date well completed 3/17/56 19
Application for plugging filed 3/16/56 19
Application for plugging approved 3/16/56 19
Plugging commenced 3/17/56 19
Plugging completed 3/17/56 19
Reason for abandonment of well or producing formation Dry

If a producing well is abandoned, date of last production _____ 19____
Was permission obtained from the Conservation Division or its agents before plugging was commenced? yes

Name of Conservation Agent who supervised plugging of this well Eldon Petty
Producing formation _____ Depth to top _____ Bottom _____ Total Depth of Well 3960 Feet
Show depth and thickness of all water, oil and gas formations.

OIL, GAS OR WATER RECORDS

CASING RECORD

FORMATION	CONTENT	FROM	TO	SIZE	PUT IN	PULLED OUT
				8 5/8	252	none

Describe in detail the manner in which the well was plugged, indicating where the mud fluid was placed and the method or methods used in introducing it into the hole. If cement or other plugs were used, state the character of same and depth placed, from _____ feet to _____ feet for each plug set.


PLUGGING RECORD

Filled with heavy rotary mud from 3960 to 245. Set Halliburton Plug from 245 to 215, using 1/2 sack hulls and 15 sacks cement through drill pipe.
Filled with heavy rotary mud from 215 to 40'. Set Halliburton Plug from 40' to cellar 0, using 10 sacks cement & 1/2 sk hulls. Job completed 7:00pm.

(If additional description is necessary, use BACK of this sheet)
Name of Plugging Contractor Trans Era Petroleum, Inc.
Address _____

STATE OF KANSAS, COUNTY OF RUSSELL, ss.
C. T. Honaker (employee of owner) or (owner or operator) of the above-described well, being first duly sworn on oath, says: That I have knowledge of the facts, statements, and matters herein contained and the log of the above-described well as filed and that the same are true and correct. So help me God
(Signature) C. T. Honaker

SUBSCRIBED AND SWORN to before me this 19th day of March, 19 56
My commission expires 1-30-57
Margie Cooper
Notary Public.

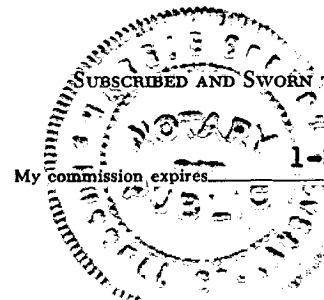

PLUGGING
FILE SEC 15 T 10 R 23W
BOOK PAGE 47 LINE 16

03-21-56
RECEIVED
STATE CORPORATION COMMISSION

15-065-00854-0000

LAW #1
Trans Era Petroleum, Inc.

SW SW NW 15-10-23
Graham County, Kansas

Total Depth: 3960'

Elev: 2395 DF

Comm: 3/4/56
Comp: 3/17/56

Casing:

Cement

8 5/8" @ 252'

150 sacks , 2% Gel, 2 sks Cal-chl.

FORMATION	DEPTH
Surface Clay	40
Shale	252
Shale - shells - sand	880
Shale	990
Sand	1040
Sandy shale & shells	1230
Sand	1290
Shale - shells - pyrite	1500
Sand - shale	1705
Shale - Red Bed	1960
Anhydrite	2000
Shale - Pyrite	2075
Shale - Lime - Pyrite	2252
Shale - Pyrite	2310
Salt - Shale	2400
Shale - Lime	3748
Lime	3960

Tops:		DEPTH
Anhydrite		1960
Heebner		3676
Toronto		3695
Kansas City		3710
ID		3960

STATE OF KANSAS)
) ss:
COUNTY OF RUSSELL)

I hereby certify that the above information is true and correct to the best of my knowledge.

C. P. Honaker

Subscribed and sworn to before me this 19th day of March, 1956.

Margie Cooper
Notary Public



RECEIVED

PLUGGING
FILE SEC 15 T 10 R 23W
BOOK PAGE 47 LINE 16