

15-195-00219-00-00


WELL PLUGGING RECORD

Trego County, Sec. 5 Twp. 12S Rge. (E) 22 (W)  
 Location as "NE/CNW $\frac{1}{4}$ SW $\frac{1}{4}$ " or footage from lines NW, SW, NW  
 Lease Owner Jones, Shelburne & Farmer, Inc.  
 Lease Name RINKER Well No. 1  
 Office Address Russell, Kansas  
 Character of Well (completed as Oil, Gas or Dry Hole) Dry Hole  
 Date well completed 2/8/50 19  
 Application for plugging filed 2/8/50 19  
 Application for plugging approved 2/8/50 19  
 Plugging commenced 2/8/50 19  
 Plugging completed 2/8/50 19  
 Reason for abandonment of well or producing formation Never Produced - Dry

If a producing well is abandoned, date of last production Never Produced 19  
 Was permission obtained from the Conservation Division or its agents before plugging was commenced? Yes

Name of Conservation Agent who supervised plugging of this well Eldon Petty  
 Producing formation None Depth to top Bottom Total Depth of Well 4165 Feet

Show depth and thickness of all water, oil and gas formations.

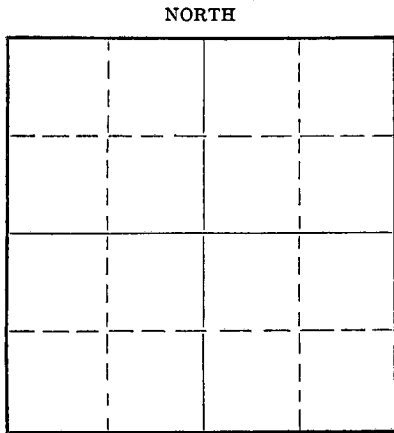

OIL, GAS OR WATER RECORDS

CASING RECORD

Formation	Content	From	To	Size	Put In	Pulled Out
Cemented with	125 sacks.			8 5/8"	200'	None

Describe in detail the manner in which the well was plugged, indicating where the mud fluid was placed and the method or methods used in introducing it into the hole. If cement or other plugs were used, state the character of same and depth placed, from feet to feet for each plug set.

- Hole filled with heavy mud.
- Halliburton plug pushed to 195' with drill pipe.
- Fifteen sacks cement mixed and spotted on top of plug through drill pipe.
- Second Halliburton plug pushed to thirty feet.
- Ten sacks cement mixed and spotted on top of plug.

FFD  
STA 02-11-1950

(If additional description is necessary, use BACK of this sheet)

Correspondence regarding this well should be addressed to Jones, Shelburne & Farmer, Inc.  
 Address Russell, Kansas


STATE OF Kansas, COUNTY OF Russell, ss.  
 John O. Farmer (employee of owner) or (owner or operator) of the above-described well,  
 being first duly sworn on oath, says: That I have knowledge of the facts, statements and matters herein contained and the log of the above-described well as filed and that the same are true and correct. So help me God.

(Signature) John O. Farmer

(Address)

SUBSCRIBED AND SWORN TO before me this 9 day of February, 1950  
 Phyllis Bethany Notary Public

My commission expires June 3, 1953

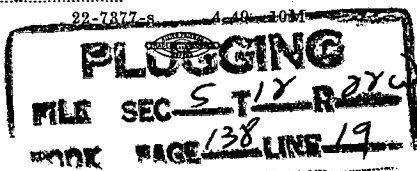

# Jones, Shelburne & Farmer, Inc.

Russell, Kansas

15-195-00219-00-00

## CONTRACTOR'S VERIFIED LOG

Operator JONES, SHELBURNE & FARMER, INC Farm Name RINKER Well No. 1

Location NW SW NW SECTION 5-12S-22W

Pool Name WILDCAT County TREGO State KANSAS

Commencement Date 1/29/50 Completion Date 2/8/50

### Log of Well

Depth		Formation	Deviation from vertical (degrees)	Remarks
From	To			
100	1025	Shale and shells		
1025	1100	Sand		
1100	1855	Shale and shells		
1855	1905	Anhydrite		
1905	2200	Shale and shells		
2200	2310	Salt		
2300	2400	Shale and shells		
2400	3700	Lime and Shale		
3700	3940	Lime		
3940	4020	Lime and shale		
4020	4100	Lime, shale and chert		
4100	4114	Cherty conglomerate		
4114	4140	Arbuckle		
4140	4165	Lime		
	4165	Total Depth		

**PLUGGING**  

FEB 11 1950  
 02-11-1950  
 TREGO COUNTY  
 KANSAS

