

CARD MUST BE SIGNED

Starting Date: 7 25 85
month day year

OPERATOR: License # 9152
 Name MAREXCO
 Address 3025 Quail Street
 City/State/Zip Lakewood, CO 80215
 Contact Person Stephen W. Marden
 Phone (303) 237-5716

CONTRACTOR: License #5671.....
 NameRvelin Drilling.....
 City/StateRussell, Kansas.....

Well Drilled For: Well Class: Type Equipment:

☒ Oil ☐ Swd ☐ Infield ☒ Mud Rotary
☐ Gas ☐ Inj ☒ Pool Ext. ☐ Air Rotary
☐ OWWO ☐ Expl ☐ Wildcat ☐ Cable

If OWWO: old well info as follows:

Operator

Well Name

Comp Date Old Total Depth

Projected Total Depth 4100 feet

Projected Formation at TD Arbuckle

Expected Producing Formations Marmaton

I certify that we will comply with K.S.A. 55-101, et seq., plus eventually plugging hole to K.C.C. specifications.

Date 7/15/85 Signature of Operator or Agent John W. Marden Title owner

API Number 15- 195-21,751-00-00

.NW. NW. SE. Sec .9. Twp .12. S, Rge 22. ☐ East
(location) ☒ West

....231.0..... Ft North from Southeast Corner of Section
231.0..... Ft West from Southeast Corner of Section
 (Note: Locate well on Section Plat on reverse side)

Nearest lease or unit boundary line330..... feet.

CountyTrego.....

Lease NameBabb..... **Well#** ..33-9.....

Domestic well within 330 feet : ☐ yes ☒ no

Municipal well within one mile : ☐ yes ☒ no

Depth to Bottom of fresh water125..... feet

Lowest usable water formationDakota Formation.....

Depth to Bottom of usable water 950 feet

Surface pipe by Alternate : 1 ☐ 2 ☒

Surface pipe to be set 250 feet

Conductor pipe if any required feet

Ground surface elevation 2,374 **feet MSL**

This Authorization Expires 1-17-86 0

Approved By 7-17-85 [Signature]


RCH for KOHE

Must be filed with the K.C.C. five (5) days prior to commencing well
This card void if drilling not started within six (6) months of date received by K.C.C.

A Regular Section of Land
1 Mile = 5,280 Ft.

RECEIVED
STATE CORPORATION COMMISSION
07-17-1985
1 5 1

CONSERVATION DIVISION
Wichita, Kansas

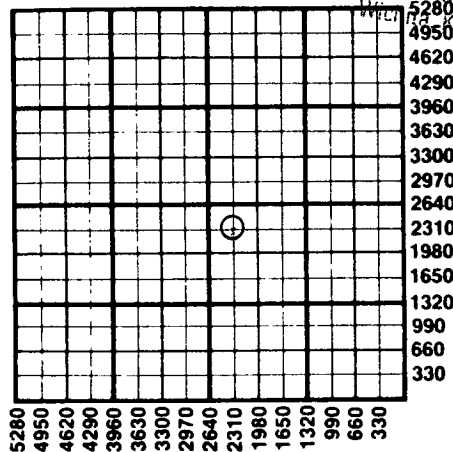

Important procedures to follow:

1. Notify District office before setting surface casing.
2. Set surface casing by circulating cement to the top.
3. File completion forms ACO-1 with K.C.C. within 90 days of well completion, following instructions on ACO-1, side 1, and including copies of wireline logs.
4. Notify District office 48 hours prior to old well workover or re-entry.
5. Prior to plugging, prepare a plugging plan, then obtain agreement from the appropriate district office for an approved plugging plan.
6. Submit plugging report (CP-4) to K.C.C. after plugging is completed.
7. Obtain an approved injection docket number before disposing of salt water.
8. Notify K.C.C. within 10 days when injection commences or terminates.
9. If an alternate 2 completion, cement in the production pipe from below any usable water to surface within 120 days of spud date.

State Corporation Commission of Kansas
Conservation Division
200 Colorado Derby Building
Wichita, Kansas 67202
(316) 263-3238