

EFFECTIVE DATE: 8-11-90

15-065-22587-00-00

FORM MUST BE TYPED
FORM C-1 4/90

State of Kansas
NOTICE OF INTENTION TO DRILL

FORM MUST BE SIGNED
ALL BLANKS MUST BE FILLED

Must be approved by the K.C.C. five (5) days prior to commencing well

Expected Spud Date 08/07/90
month day year

S/2 SW NE 11 10 21 ~~West~~ East ✓
..... Sec Twp S, Rg West

OPERATOR: License # 3007 ✓
WESTERN KANSAS EXPLORATION
Name: P.O. BOX 128
Address: HAYS KS 67601
City/State/Zip: STAN YOUNGER
Contact Person: (713) 628-2296
Phone:

2970
1980
..... feet from South line of Section
..... feet from East line of Section
(Note: Locate well on Section Plat on Reverse Side)

CONTRACTOR: License # 4083 ✓
WESTERN KANSAS DRILLING
Name:

GRAHAM
County: DEWBURG
Lease Name: UNKNOWN Well #:
Field Name:
Is this a Prorated Field? ARBUCKLE Yes XX no ✓

Well Drilled For: Well Class: Type Equipment:
XX Oil ... Inj XX Infield XX Mud Rotary ✓
... Gas ... Storage ... Pool Ext. ... Air Rotary
... OWD ... Disposal ... Wildcat ... Cable
... Seismic; ... # of Holes

Target Formation(s): 330
Nearest lease or unit boundary: 2250
Ground Surface Elevation: feet MSL

If OWD: old well information as follows:
Operator:
Well Name:
Comp. Date: Old Total Depth

Domestic well within 330 feet: ... yes XX no ✓
Municipal well within one mile: ... yes XX no ✓
Depth to bottom of fresh water: 300
Depth to bottom of usable water: 100 ✓
Surface Pipe by Alternate: ... 1 XX 200 ✓

Directional, Deviated or Horizontal wellbore? ... yes XX no ✓
If yes, total depth location:

Length of Surface Pipe Planned to be set: *****
Length of Conductor pipe required: 3800
Projected Total Depth: ARBUCKLE
Formation at Total Depth:

Water Source for Drilling Operations:
... well ... farm pond ... other ✓

DWR Permit #:
Will Cores Be Taken?: ... yes XX no ✓
If yes, proposed zone:

AFFIDAVIT

The undersigned hereby affirms that the drilling, completion and eventual plugging of this well will comply with K.S.A. 55-101, et. seq.

- It is agreed that the following minimum requirements will be met:
1. The appropriate district office shall be notified before setting surface pipe;
 2. The minimum amount of surface pipe as specified above shall be set by circulating cement to the top; in all cases surface pipe shall be set through all unconsolidated materials plus a minimum of 20 feet into the underlying formation;
 3. If the well is dry, a plugging proposal shall be submitted to the district office. An agreement between the operator and the district office on plug length and placement is necessary prior to plugging;
 4. The appropriate district office will be notified before well is either plugged or production casing is cemented in;
 5. If an Alternate II completion, production pipe shall be cemented from below any usable water to surface within 120 days of spud date. In all cases, notify district office prior to any cementing.

I hereby certify that the statements made herein are true and to the best of my knowledge and belief.
08/06/90
Date: Signature of Operator or Agent: SEARCH, INC. Title: AGENT

FOR KCC USE:
065
API # 15- 065-22587
Conductor pipe required None feet
Minimum surface pipe required 200 feet per Alt. ● (2)
Approved by: me 8-6-90
EFFECTIVE DATE: 8-11-90
This authorization expires: 2-6-91
(This authorization void if drilling not started within 6 months of effective date.)
Spud date: _____ Agent: _____

RECEIVED
STATE CORPORATION COMMISSION
8-6-1990
AUG 6 1990
CONSERVATION DIVISION
Wichita, Kansas

REMEMBER TO:

- File Drill Pit Application (form CDP-1) with Intent to Drill;
- File Completion Form ACO-1 within 120 days of spud date;
- File acreage attribution plat according to field proration orders;
- Notify appropriate district office 48 hours prior to workover or re-entry;
- Submit plugging report (CP-4) after plugging is completed;
- Obtain written approval before disposing or injecting salt water.


PLAT OF ACREAGE ATTRIBUTABLE TO A WELL

State Corporation Commission, Conservation Division
200 Colorado Derby Bldg. Wichita, Kansas 67202

OPERATOR WESTERN KANSAS EXPLORATION LOCATION OF WELL:
 LEASE DeYoung 2970 feet north of SE corner
 WELL NUMBER 7 1980 feet west of SE corner
 FIELD UNKNOWN NE Sec. 11 T 10 R 21 E/W
 COUNTY GRAHAM
 NO. OF ACRES ATTRIBUTABLE TO WELL _____ IS SECTION _____ REGULAR _____ IRREGULAR?
 DESCRIPTION OF ACREAGE _____ NE IF IRREGULAR, LOCATE WELL FROM NEAREST CORNER BOUNDARY.

NOTE: If plat depicted is insufficient for your circumstances, you may attach your own scaled or surveyed plat.

PLAT

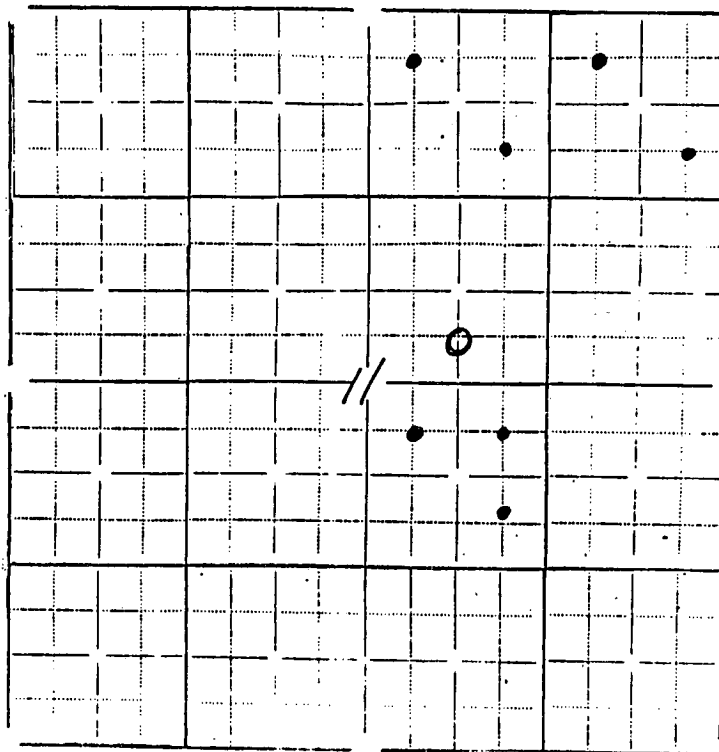

In plotting the proposed location of the well, you must show:

- 1) The manner in which you are using the depicted plat by identifying section lines, i.e. 1 section, 1 section with 8 surrounding partial sections, 4 sections, 16 sections, etc.;
- 2) the well's location relative to the location of other wells producing from the same common source of supply in adjoining drilling units, pursuant to K.A.R. 82-3-108, 82-3-207, 82-3-312, or special orders of the Commission;
- 3) the distance of the proposed drilling location from the section's east and south lines; and
- 4) the distance to the nearest lease or unit boundary line.

I hereby certify that the statements made herein are true and to the best of my knowledge and belief.

Signature of Operator or Agent *C. J. P. [Signature]*
 Date 08/06/90 Title Agent