


STATE OF KANSAS
STATE CORPORATION COMMISSION

WELL PLUGGING RECORD

Give All Information Completely
Make Required Affidavit
Mail or Deliver Report to:
Conservation Division
State Corporation Commission
211 No. Broadway
Wichita, Kansas

NORTH

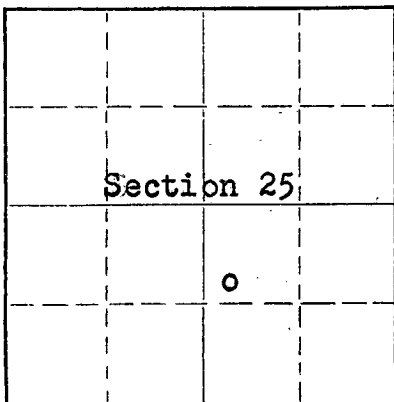

Locate well correctly on above
Section Plat

Graham County. Sec. 25 Twp. 10 Rge. 21 (S) W (W)
Location as "NE/CNW/SW" or footage from lines SW NW SE
Lease Owner Petroleum, Inc.
Lease Name White Well No. 4
Office Address Route 2, Great Bend, Kansas
Character of Well (completed as Oil, Gas or Dry Hole) Dry hole
Date well completed August 9 19 58
Application for plugging filed Sept. 30 19 58
Application for plugging approved October 1 19 58
Plugging commenced October 5 19 58
Plugging completed October 8 19 58
Reason for abandonment of well or producing formation No producible zones

If a producing well is abandoned, date of last production none 19
Was permission obtained from the Conservation Division or its agents before plugging was commenced? yes

Name of Conservation Agent who supervised plugging of this well A. D. Fabricius
Producing formation ----- Depth to top --- Bottom --- Total Depth of Well 3717 Feet
Show depth and thickness of all water, oil and gas formations.

OIL, GAS OR WATER RECORDS

CASING RECORD

FORMATION	CONTENT	FROM	TO	SIZE	PUT IN	PULLED OUT
				8 5/8"	250'	None
<u>Arbuckle</u>	<u>Water and little oil</u>	<u>3710'</u>	<u>3717'</u>	<u>5 1/2"</u>	<u>3710'</u>	<u>3000'</u>

Describe in detail the manner in which the well was plugged, indicating where the mud fluid was placed and the method or methods used in introducing it into the hole. If cement or other plugs were used, state the character of same and depth placed, from feet to feet for each plug set.

Filled hole with crushed rock from 3717' to 3700' followed by 5 sacks cement. Mud up to 250' and made solid rock bridge. Placed 25 sacks cement on top of bridge. Mud up to 40' and made solid rock bridge. Filled hole to base of well cellar with 10 sacks cement.

RECEIVED
STATE CORPORATION COMMISSION
OCT 16 1958
OCT 16 1958
CONSERVATION DIVISION
WICHITA, KANSAS


(If additional description is necessary, use BACK of this sheet)
Name of Plugging Contractor Morgan Well Plugging Service
Address 102 W. 18th Street, Hutchinson, Kansas

STATE OF Kansas, COUNTY OF Barton, ss.
Don Searle (employee of owner) or (~~owner~~) of the above-described

well, being first duly sworn on oath, says: That I have knowledge of the facts, statements, and matters herein contained and the log of the above-described well as filed and that the same are true and correct. So help me God.

(Signature) Don Searle
Route 2, Great Bend, Kansas
(Address)

SUBSCRIBED AND SWORN TO before me this 14th day of October, 19 58
My commission expires July 11, 1960
Notary Public.

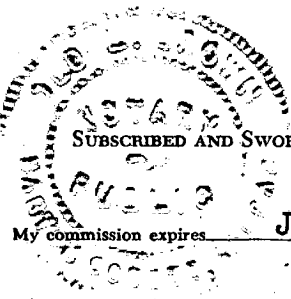

PLUGGING
FILE SEC 25 T. 10 R. 21W
BOOK PAGE 133 LINE 18

WELL LOG

COMPANY PETROEUM, INCORPORATED

SEC. 25 T. 10S R. 21W

FARM WHITE

NO. 4

LOC. SW, NW, SE


TOTAL DEPTH 3713'

COUNTY GRAHAM CO., KANSAS

COMM. July 21, 1958

COMP. July 30, 1958

CONTRACTOR GARVEY DRILLING COMPANY

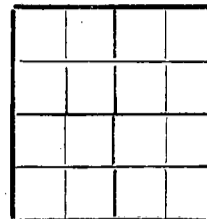

CASING 8 5/8" @ 250' W/175 sax.
5 1/2" @ 3710' W/75 sax.

ELEVATION 2122' DF

PRODUCTION PLUGGED & ABANDONED

FIGURES INDICATE BOTTOM OF FORMATIONS

15	Surface soil
200	Shale & yellow clay
250	Blue shale
500	Shale & shells
800	Shale & sand
950	Sand
1050	Iron pyrite
1245	Sand
1568	Red bed & shale
1625	Anhydrite
1840	Shale & shells
1950	Shale
2475	Shale & lime
2550	Lime & shale
2560	Shale
3050	Shale & lime
3210	Lime & shale
3372	Lime
3425	Lime & chert
3610	Lime
3685	Lime & conglomerate
3710	Lime, chert & shale
3713	Arbuckle
3713	T. D.

PLUGGING
 FILE SEC 25 T 10 R 21W
 BOOK PAGE 133 LINE 18

State of KANSAS }
 County of BARTON } ss:

I, VERNE A. MORRIS of GARVEY DRILLING COMPANY
 upon oath state that the above and foregoing is a true and correct copy of the log of the #4 WHITE well

Subscribed and sworn to before me this 7th day of October 19 58

My Commission Expires: July 11, 1960

Verne A. Morris
 10-16-1958
 DIVISION
Del. J. Braun
 NOTARY PUBLIC