


WELL PLUGGING RECORD

Give All Information Completely  
Make Required Affidavit  
Mail or Deliver Report to:  
Conservation Division  
State Corporation Commission  
800 Bittling Building  
Wichita, Kansas

Graham County. Sec. 25 Twp. 10S Rge. 21 (E) W (W)

Location as "NE/CNW%SW%" or footage from lines SE SE NW  
Lease Owner Anderson-Prichard Oil Corporation  
Lease Name Herrold Well No. 9  
Office Address Liberty Bank Bldg., Oklahoma City, Oklahoma  
Character of Well (completed as Oil, Gas or Dry Hole) Dry hole  
Date well completed April 30 1954  
Application for plugging filed April 30 1954  
Application for plugging approved April 30 1954  
Plugging commenced April 30 1954  
Plugging completed April 30 1954  
Reason for abandonment of well or producing formation Dry Hole

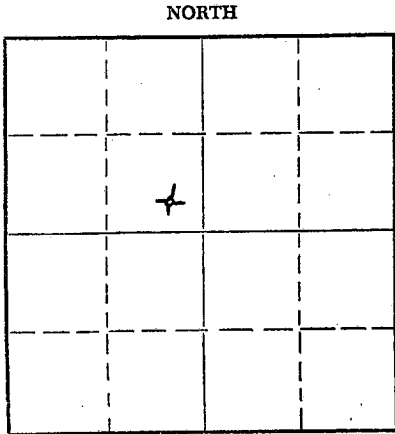

Locate well correctly on above Section Plat

If a producing well is abandoned, date of last production \_\_\_\_\_ 19\_\_\_\_  
Was permission obtained from the Conservation Division or its agents before plugging was commenced? Yes

Name of Conservation Agent who supervised plugging of this well Eldon Petty  
Producing formation \_\_\_\_\_ Depth to top \_\_\_\_\_ Bottom \_\_\_\_\_ Total Depth of Well 3912 Feet  
Show depth and thickness of all water, oil and gas formations.

OIL, GAS OR WATER RECORDS

CASING RECORD

FORMATION	CONTENT	FROM	TO	SIZE	PUT IN	PULLED OUT
		0	235	8 5/8"	235	None

Describe in detail the manner in which the well was plugged, indicating where the mud fluid was placed and the method or methods used in introducing it into the hole. If cement or other plugs were used, state the character of same and depth placed, from \_\_\_\_\_ feet to \_\_\_\_\_ feet for each plug set.


From 3912' to 226 1/2' - heavy rotary mud  
226 1/2' to 225' - wooden plug  
225' to 179' - 15 sacks cement & 1/2 sack hulls  
179' to 41 1/2' - heavy rotary mud  
41 1/2' to 40' - wooden plug  
40' to 6' - 10 sacks cement & 1/2 sack hulls  
6' to surface - cellar

(If additional description is necessary, use BACK of this sheet)

Name of Plugging Contractor Glenn W. Peel  
Address P.O. Box 359, Hoisington, Kansas

STATE OF KANSAS, COUNTY OF BARTON, ss.  
Glenn W. Peel (employee of owner) or (owner or operator) of the above-described well, being first duly sworn on oath, says: That I have knowledge of the facts, statements, and matters herein contained and the log of the above-described well as filed and that the same are true and correct. So help me God. GLENN W. PEEL

(Signature) BY: [Signature]  
P.O. Box 359, Hoisington, Kansas  
(Address)

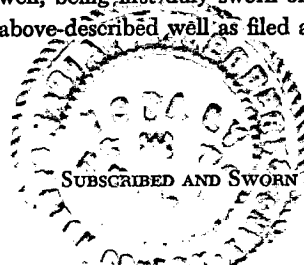

SUBSCRIBED AND SWORN to before me this 6<sup>th</sup> day of May, 19 54

Marnie M. Herbert Notary Public.

My commission expires June 4, 1955

24-7368-5 3-53-20M

**PLUGGING**  
FILE SEC 25 T 10 R 21W  
BOOK PAGE 31 LINE 29

RECEIVED  
STATE CORPORATION COMMISSION  
5-8-1954  
MAY 3 1954  
CONSERVATION DIVISION  
Wichita, Kansas

DRILLERS' LOG

Company: Anderson-Prichard Oil Corporation

SE SE NW

Farm Name: Herrold

Well No. 9

Sec. 25, Twp. 10S, Rge. 21W,

Total Depth: 3912'

County: Graham,  
Kansas

Comm: 4-20-54 Comp: 4-30-54

Contractor: Glenn W. Peel

Elevation:

Casing: 8 5/8" 235' cem.

Production:

Figures below indicate bottoms of formations:

Surface soils and sand	0 -	40
Shale		235
Shale and shells		400
Shale		750
Sand and shale		1100
Sand		1330
Shale		1605
Anhydrite		1650
Shale and shells		1980
Lime and shale		2150
Lime		2540
Lime and shale		2825
Lime		2935
Lime and shale		3085
Lime		3739
Conglomerate		3912
Total Depth		3912

This is to certify that the above information is to the best of our knowledge, true and correct.

GLENN W. PEEL

BY: Glenn W. Peel

SUBSCRIBED AND SWORN to before me this 6<sup>th</sup> day of May, 1954.

My commission expires: June 4, 1955

Morris M. Herbert  
Notary Public

5-8-1954

**PLUGGING**  
REC 25 T 10 R 21W  
PAGE 31 LINE 29