

15-065-02345-00-00


STATE OF KANSAS
STATE CORPORATION COMMISSION

WELL PLUGGING RECORD

Give All Information Completely
Make Required Affidavit
Mail or Deliver Report to:
Conservation Division
State Corporation Commission
800 Biting Building
Wichita, Kansas

Graham County, Sec. 25 Twp. 10S Rge. 21 (E) W (W)
Location as "NE/CNW%SW%" or footage from lines C N/2 N/2 NW/4
Lease Owner Anderson-Prichard Oil Corporation
Lease Name Herrold Well No. 10
Office Address Liberty Bank Bldg., Oklahoma City, Oklahoma
Character of Well (completed as Oil, Gas or Dry Hole) Dry hole
Date well completed May 13, 1954
Application for plugging filed May 13, 1954
Application for plugging approved May 13, 1954
Plugging commenced May 13, 1954
Plugging completed May 13, 1954
Reason for abandonment of well or producing formation Dry hole

NORTH

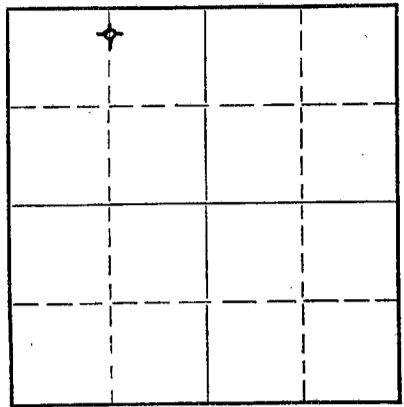

Locate well correctly on above Section Plat

If a producing well is abandoned, date of last production _____ 19____
Was permission obtained from the Conservation Division or its agents before plugging was commenced? Yes

Name of Conservation Agent who supervised plugging of this well Eldon Petty
Producing formation _____ Depth to top _____ Bottom _____ Total Depth of Well 3819 Feet
Show depth and thickness of all water, oil and gas formations.

OIL, GAS OR WATER RECORDS

CASING RECORD

FORMATION	CONTENT	FROM	TO	SIZE	PUT IN	PULLED OUT
		0	233'	8 5/8"	233'	none

Describe in detail the manner in which the well was plugged, indicating where the mud fluid was placed and the method or methods used in introducing it into the hole. If cement or other plugs were used, state the character of same and depth placed, from _____ feet to _____ feet for each plug set.

3819' to 211 1/2' - heavy rotary mud
211 1/2' to 210' - wooden plug
210' to 164' - 15 sacks cement
164' to 41 1/2' - heavy rotary mud
41 1/2' to 40' - wooden plug
40' to 6' - 10 sacks cement
6' to surface - cellar

RECEIVED
STATE CORPORATION COMMISSION
5-21-1954
CONSERVATION DIVISION
Wichita, Kansas

(If additional description is necessary, use BACK of this sheet)
Name of Plugging Contractor Glenn W. Peel
Address P.O. Box 359, Hoisington, Kansas

STATE OF KANSAS, COUNTY OF BARTON, ss.
Glenn W. Peel (employee of owner) or (owner or operator) of the above-described well, being first duly sworn on oath, says: That I have knowledge of the facts, statements, and matters herein contained and the log of the above-described well as filed and that the same are true and correct. So help me God. GLENN W. PEEL

(Signature) _____ BY: [Signature]
P.O. Box 359, Hoisington, Kansas
(Address)

SUBSCRIBED AND SWORN to before me this 17th day of May, 19 54

My commission expires June 4, 1955 Marion M. Herbert Notary Public.

PLUGGING
FILE SEC 25 T 10 R 21W
BOOK PAGE 34 LINE 36

DRILLERS' LOG

Company: Anderson-Prichard Oil Corp.

C N/2 N/2 NW/4
Sec. 25, Twp. 10S, Rge. 21W,

Farm Name: Herrold Well No. 10

County: Graham,
Kansas

Total Depth: 3819'

Comm: 5-3-54 Comp: 5-13-54
Contractor: Glenn W. Peel

Elevation:

Production: Dry

Casing: 8 5/8" 233' cem.

Figures below indicate bottoms of formations:

Top soils and post rock	0 -	75
Shale		235
Shale and shells		650
Sand and shale		1125
Sand		1250
Shale		1645
Anhydrite		1690
Shale and shells		2105
Shale		2265
Shale and Lime		2535
Lime		2660
Shale and lime		3375
Lime		3705
Conglomerate		3810
Arbuckle		3819
Total Depth		3819

This is to certify that the above information is to the best of our knowledge, true and correct.

GLENN W. PEEL

BY: *Glenn W. Peel*

SUBSCRIBED AND SWORN to before me this 17th day of May, 1954.

My commission expires: June 4, 1955

Marion M. Weather
Notary Public

5-21-1954

FLUGGING
PLU SEC 25 T 10 R 21 N
PAGE 34 OF 36