


WELL PLUGGING RECORD

Give All Information Completely  
Make Required Affidavit  
Mail or Deliver Report to:  
Conservation Division  
State Corporation Commission  
800 Bittling Building  
Wichita, Kansas

Graham County, Sec. 25 Twp. 10S. Rge. 21 (E) W. (W)

Location as "NE/CNW $\frac{1}{4}$ SW $\frac{1}{4}$ " or footage from lines NE $\frac{1}{4}$  SW $\frac{1}{4}$  NW $\frac{1}{4}$   
Lease Owner Anderson-Prichard Oil Corp.  
Lease Name Herrold Well No. 2  
Office Address Liberty Bank Building, Oklahoma City 2, Okla.  
Character of Well (completed as Oil, Gas or Dry Hole) Dry Hole  
Date well completed August 8 1952  
Application for plugging filed August 8 1952  
Application for plugging approved August 8 1952  
Plugging commenced August 8 1952  
Plugging completed August 8 1952  
Reason for abandonment of well or producing formation Well completed as  
Dry hole

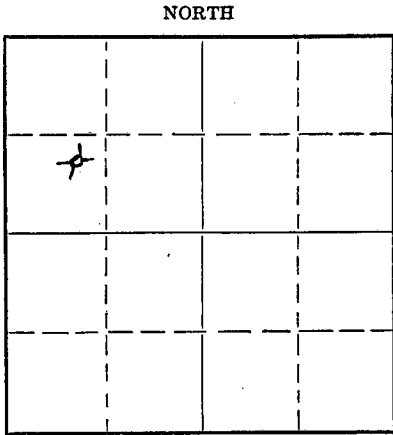

Locate well correctly on above Section Plat

If a producing well is abandoned, date of last production 19...  
Was permission obtained from the Conservation Division or its agents before plugging was commenced? Yes

Name of Conservation Agent who supervised plugging of this well E. R. Petty  
Producing formation Depth to top Bottom Total Depth of Well 3925 Feet  
Show depth and thickness of all water, oil and gas formations.

OIL, GAS OR WATER RECORDS

CASING RECORD

Formation	Content	From	To	Size	Put In	Pulled Out
		0	215	8 5/8	215	None

Describe in detail the manner in which the well was plugged, indicating where the mud fluid was placed and the method or methods used in introducing it into the hole. If cement or other plugs were used, state the character of same and depth placed, from feet to feet for each plug set.

3925' - 201 $\frac{1}{2}$ ' - Heavy Rotary Mud  
201 $\frac{1}{2}$ ' - 200' - Wooden Plug  
200' - 154' - 15 sacks cement  
154' - 41 $\frac{1}{2}$ ' - Heavy Rotary Mud  
41 $\frac{1}{2}$ ' - 40' - Wooden Plug  
40' - 6' - 10 sacks cement  
6' Surface Cement

(If additional description is necessary, use BACK of this sheet)

Name of Plugging Contractor Glenn W. Peel  
Address P.O. Box 359, Hoisington, Kansas

STATE OF Kansas, COUNTY OF Barton, ss.

Glenn W. Peel (employee of owner) or (owner/operator) of the above-described well, being first duly sworn on oath, says: That I have knowledge of the facts, statements, and matters herein contained and the log of the above-described well as filed and that the same are true and correct. So help me God. GLENN W. PEEL

BY: *Manian M. Hartert*  
(Signature) P.O. Box 359, Hoisington, Kansas  
(Address)

SUBSCRIBED AND SWORN to before me this 9th day of August, 1952

My commission expires June 4, 1955

23-8390-s

RECEIVED  
STATE CORPORATION COMMISSION  
6-51-20M  
8-12-1952  
Manian M. Hartert  
Notary Public.

PLUGGING  
FILE SEC 25 T10 R 21  
BOOK PAGE 36 NE 36

CONSERVATION DIVISION  
Wichita, Kansas

DRILLER'S LOG

Company: Anderson-Prichard Oil Corp.

NE/4 SW/4 NW/4  
Sec. 25, Twp. 10S, Rge. 21W

Farm: Herrold Well No. 2

County: Graham,  
Kansas

Comm: 7-28-52 Comp: 8-8-52

Total Depth: 3925'

Contractor: Glenn W. Peel

Elevation:

Casing: 8 5/8" 215' cem.

Production: Dry

Figures below indicate bottom of formations .

Surface Rock & Clay	218
Shale & Sand	1280
Shale	1635
Anhydrite	1665
Shale & Shells	1700
Shale	2020
Lime & Shale	2400
Lime	2625
Lime & Shale	2730
Shale	2845
Lime & Shale	3325
Lime	3763
Conglomerate	3880
Conglomerate & Arbuckle	3925
Total Depth	3925

This is to certify that the above information is, to the best of our knowledge, true and correct.

GLENN W. PEEL

BY: Wm Herbert

SUBSCRIBED AND SWORN to before me this 9<sup>th</sup> day of August, 1952.

My commission expires June 4, 1955

Marion M. Herbert  
Notary Public



**PLUGGING**  
WELL SEC-25T10N21W  
BOOK PAGE-36-36

RECEIVED  
STATE CORPORATION COMMISSION  
8-12-1952  
AUG 12 1952  
CONSERVATION DIVISION  
Wichita, Kansas