

STATE OF KANSAS
STATE CORPORATION COMMISSION

Give All Information Completely
Make Required Affidavit
Mail or Deliver Report to:
Conservation Division
State Corporation Commission
212 No. Market
Wichita, Kansas

WELL PLUGGING RECORD

Graham County, Sec. 25 Twp. 10S Rge. (E) 21W(W)

Location as "NE/CNWxSWx" or footage from lines. NW 1/4 SW 1/4 NE 1/4

Lease ~~Owner~~ Operator: Birmingham - Bartlett Drilling Co.

Lease Name Hincks Well No. 2

Office Address 300 Kaufman Bldg., Wichita, Kansas, 67202

Character of Well (completed as Oil, Gas or Dry Hole) Oil Well

Date well completed April 26, 19 54

Application for plugging filed Oct. 12, 1966 & by letter Feb. 23, 19 70

Application for plugging approved February 24, 19 70


Plugging commenced March 9, 19 70

Plugging completed March 9, 19 70

Reason for abandonment of well or producing formation Production declined to a point where well no longer economical to operate.

If a producing well is abandoned, date of last production September 24, 19 66

Was permission obtained from the Conservation Division or its agents before plugging was commenced? Yes

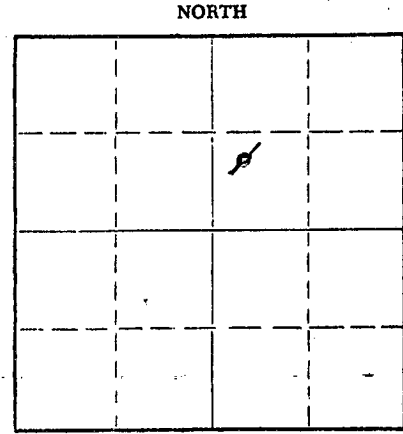

Locate well correctly on above Section Plat

Name of Conservation Agent who supervised plugging of this well W. L. Nichols

Producing formation Arbuckle Depth to top 3721' Bottom Total Depth of Well 3727 Feet

Show depth and thickness of all water, oil and gas formations.

OIL, GAS OR WATER RECORDS

CASING RECORD

FORMATION	CONTENT	FROM	TO	SIZE	PUT IN	PULLED OUT
		0	158'	8-5/8"	158'	None
		0	3726'	5-1/2"	3723'	None

Describe in detail the manner in which the well was plugged, indicating where the mud fluid was placed and the method or methods used in introducing it into the hole. If cement or other plugs were used, state the character of same and depth placed, from feet to feet for each plug set.

March 9, 1970-

Shirk Well Service Co. Run 2" tubing down to 2890', where bottom of hole was plugged off. Indicating that there was approx. 837' of fillup in the hole; 10-Sacks of cement was spotted at 2860'; 30 Sks. of Gel was spotted at 2704'. Hole circulated to the surface; Spotted tubing at 780' and pumped 50 Sks. of cement into hole; Spotted tubing at 180'. Pumped 10-Sks. of cement into hole; Pulled tubing out of hole and pumped 5 Sks. of cement into casing filling casing to the base of the cellar;

RECEIVED
STATE CORPORATION COMMISSION
5-19-1970
MAR 19 1970
CONSERVATION DIVISION
Wichita, Kansas

(If additional description is necessary, use BACK of this sheet)

Name of Plugging Contractor Shirk Well Service
Address Ellis, Kansas

STATE OF KANSAS COUNTY OF SEDGWICK
Chas. H. Keevert, Production Supt. of Birmingham - Bartlett Drilling Co., operator (employee of owner) or (owner or operator) of the above-described well, being first duly sworn on oath, says: That I have knowledge of the facts, statements, and matters herein contained and the log of the above-described well as filed and that the same are true and correct. So help me God.

(Signature) Chas. H. Keevert
Rt. 1, 1806 Tracy Lane, Hutchinson, Ks., 67501 (Address)

SUBSCRIBED AND SWORN TO before me this 16th day of March, 1970.

My commission expires November 29, 1970

Vivian F. Yinger
Notary Public.



MINCKS NO. 2 WELL

LOCATION:	NW/4 SW/4 NE/4 Section 25-108 21W Graham County, Kansas	SPUEDDED: 4-13-54 COMPLETED: 4-22-54
OPERATOR and CONTRACTOR:	Birmingham-Bartlett Drilling Co. 300 Kaufman Building Wichita, Kansas	
SURFACE CASING:	8 5/8" casing cemented at 158' with 125 sacks cement and 2 cc.	
OIL STRING:	5 1/2" OD 15.5# J-55 R-2 mals casing set at 3723' with 100 sacks cement	

LOG

(Figures indicate bottom of formation)

0	158	Clay and shale
	1120	Shale and shells
	1290	Sand
	1605	Shale and shells
	1650	Anhydrite
	2035	Shale and shells
	3220	Shale and lime
	3681	Lime
	3721	Conglomerate
	3726	Lime
	3726	RTD

RECEIVED
STATE CORPORATION COMMISSION
10-19-1966
807 18 1966
CORPORATION DIVISION
WICHITA, KANSAS

The undersigned, Richard Hindery, one of the partners of Birmingham-Bartlett Drilling Co., hereby certifies that the above is a true and correct log of the formations encountered in drilling the Mincks No. 2 Well as shown in the daily drilling reports.

BIRMINGHAM-BARTLETT DRILLING CO.

By Richard Hindery

Subscribed and sworn to before me
this 27th day of April, 1954.

Beverly Larson
Notary Public

My commission expires October 2, 1954

