

STATE OF KANSAS
STATE CORPORATION COMMISSION

WELL PLUGGING RECORD

All Information Completely
Make Required Affidavit
Mail or Deliver Report to:
Conservation Division
State Corporation Commission
211 No. Broadway
Wichita, Kansas

Ellis County, Sec. 15 Twp. 13S Rge. XX 20 (W)

Location as "NE/CNW/SW" or footage from lines SE SW NW

Lease Owner Peel-Hardman Oil Operators

Lease Name Gerber Well No. 1

Office Address R.R. #3, Box 144B, Wichita 15, Kansas

Character of Well (completed as Oil, Gas or Dry Hole) Dry Hole

Date well completed 11-23 1958

Application for plugging filed 11-23 1958

Application for plugging approved 11-23 1958


Plugging commenced 11-23 1958

Plugging completed 11-23 1958

Reason for abandonment of well or producing formation Dry Hole

If a producing well is abandoned, date of last production 19

Was permission obtained from the Conservation Division or its agents before plugging was commenced? Yes

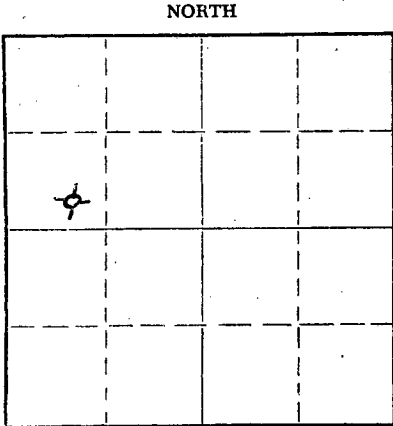

Locate well correctly on above Section Plat

Name of Conservation Agent who supervised plugging of this well Eldon Petty

Producing formation _____ Depth to top _____ Bottom _____ Total Depth of Well 3836 Feet

Show depth and thickness of all water, oil and gas formations.


OIL, GAS OR WATER RECORDS

CASING RECORD

FORMATION	CONTENT	FROM	TO	SIZE	PUT IN	PULLED OUT
		0	200'	8 5/8"	200	None

Describe in detail the manner in which the well was plugged, indicating where the mud fluid was placed and the method or methods used in introducing it into the hole. If cement or other plugs were used, state the character of same and depth placed, from _____ feet to _____ feet for each plug set.

- From 3836' to 602' - Heavy Rotary Mud
- " 602' to 600' - Howco Plug
- " 600' to 538' - 20 sacks Cement
- " 538' to 182' - Heavy Rotary Mud
- " 182' to 180' - Howco Plug
- " 180' to 134' - 15 sacks Cement
- " 134' to 42' - Heavy Rotary Mud
- " 42' to 40' - Howco Plug
- " 40' to 6' - 10 sacks Cement
- " 6' to surface - Cellar

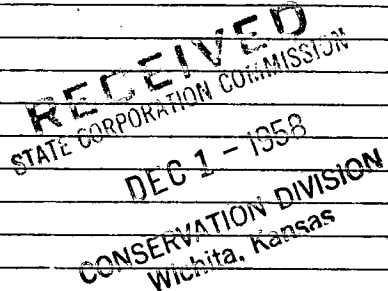

(If additional description is necessary, use BACK of this sheet)

Name of Plugging Contractor _____

Address _____

STATE OF Kansas COUNTY OF Sedgwick ss.

William Herbert (employee of owner) of the above-described

well, being first duly sworn on oath, says: That I have knowledge of the facts, statements, and matters herein contained and the log of the above-described well as filed and that the same are true and correct. So help me God.

(Signature) *William Herbert*

R. R. #3, Box 144B, Wichita 15, Kansas (Address)

SUBSCRIBED AND SWORN TO before me this 28th day of November, 1958

Marian M. Herbert Notary Public.

My commission expires March 4, 1962

PLUGGING
FILE SEC. 15 T. 13 R. 20W
BOOK PAGE 146 LINE 40

DRILLER'S LOG

Company: Peel-Hardman Oil Operators

Farm: Gerber Well No. 1

Total Depth: 3836'

Comm.: 11-13-58 Comp.: 11-23-58

Casing: 8 5/8" @ 200' Cem.

SE SW NW
Sec. 15-Twp.13S-Rge.20W,

County: Ellis,
Kansas

Elevation:

Production: Dry

Figures below indicate bottom of formations

Post Rock	0	20'
Shale and sand		200
Shale and shells		1000
Sand		1200
Anhydrite		1535
Shale and shells		2125
Shale and lime		2300
Lime		2485
Shale and lime		3020
Shale		3110
Shale and lime		3335
Lime		3836
Total Depth		3836

This is to certify that the above information is to the best of my knowledge true and correct.

GLENN W. PEEL DRILLING COMPANY

BY: *Glenn W. Peel*

SUBSCRIBED AND SWORN TO before me this 28th day of November, 1958.

My commission expires March 4, 1962.

Marian M. Herbert
Notary Public

PLUGGING
FILE SEC. 15 T. 13 R. 20W
BOOK PAGE 148 LINE 40