

Give All Information Completely
Make Required Affidavit
Mail or Deliver Report to:
Conservation Division
State Corporation Commission
212 No. Market
Wichita, Kansas

WELL PLUGGING RECORD

Graham County. Sec. 28 Twp. 10S Rge. 23 (E) W (W)
Location as "NE/CNW/SW" or footage from lines SE SW NE


Lease Owner Sun Oil Company
Lease Name Diebolt LKC Unit Tract 12 Well No. 4
Office Address 800 Security Life Bldg., Denver, Colo.

Character of Well (completed as Oil, Gas or Dry Hole) Oil
Date well completed 9-3- 1974
Application for plugging filed 8-27 1974
Application for plugging approved 8-29 1974
Plugging commenced 11-14 1974
Plugging completed 11-21 1974

Reason for abandonment of well or producing formation State regulations
require plugging

If a producing well is abandoned, date of last production February 1969

Was permission obtained from the Conservation Division or its agents before plugging was commenced? Yes

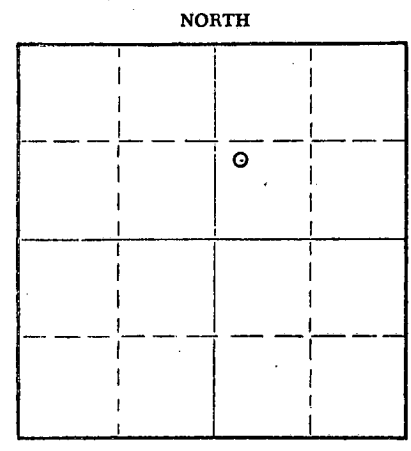

Locate well correctly on above Section Plat

Name of Conservation Agent who supervised plugging of this well W. L. Nichols
Producing formation Lansing Kansas City Depth to top 3624 Bottom 3865 Total Depth of Well 3911 Feet
Show depth and thickness of all water, oil and gas formations.

OIL, GAS OR WATER RECORDS

CASING RECORD

FORMATION	CONTENT	FROM	TO	SIZE	PUT IN	PULLED OUT
		0	202	8 5/8	202	0
		0	3911	5	3911	73

Describe in detail the manner in which the well was plugged, indicating where the mud fluid was placed and the method or methods used in introducing it into the hole. If cement or other plugs were used, state the character of same and depth placed, from _____ feet to _____ feet for each plug set.

Dumped 25 sacks of sand at plug back total dept 3575'. Displaced hole with 5 sacks of hulls, 11 sacks of gel, 70 sacks of cement, 11 sacks of gel, Released casing plug. Displaced hole with 25 sacks of cement, 3 sacks gel, 10 sacks of cement. Filled hole to surface.

RECEIVED
STATE CORPORATION COMMISSION
NOV 25 1974
CONSERVATION DIVISION
Wichita, Kansas

(If additional description is necessary, use BACK of this sheet)

Name of Plugging Contractor Charles Crowe Drilling Co.
Address Box 706, Hays, Kansas

STATE OF COLORADO COUNTY OF DENVER, ss.
D. A. Coppedge (employee of owner) or (~~owner or operator~~) of the above-described well, being first duly sworn on oath, says: That I have knowledge of the facts, statements, and matters herein contained and the log of the above-described well as filed and that the same are true and correct. So help me God.

(Signature) [Signature]

800 Security Life Bldg., Denver, Co 80202
(Address)

SUBSCRIBED AND SWORN TO before me this 22nd day of November, 19 74

My commission expires Nov. 22, 1975

Mary Marson
Notary Public.

My Commission expires Nov. 22, 1975

WELL LOG BUREAU--KANSAS GEOLOGICAL SOCIETY
508 East Murdock, Wichita, Kansas

COPY

12-4


Company- GOLDEN CAT DRILLING & SERVICING CO.
Farm-Wickizer "A" No. 4

SEC. 28 T. 10 R. 23W
NW SW NE

Total Depth. 3911
Comm 8-19-54
Shot or Treated.
Contractor.
issued. 2-19-55

Comp. 9-3-54

County Graham
KANSAS

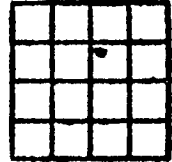

Elevation. 2376 RB

Production. 367 BO & MJ

Figures Indicate Bottom of Formations.

clay, sand & shells	202
shale & shells	1890
Anhydrite	1935
shale & shells	2170
lime & shale	3667
lime	3872
lime & shale	3911
Total depth	

Scout Tops:	
Lansing	3624
Base Kansas City	3865

RECEIVED
STATE CORPORATION COMMISSION
8-29-1974
AUG 29 1974
CONSERVATION DIVISION
Wichita, Kansas