

STATE OF KANSAS
STATE CORPORATION COMMISSION


Form CP-4

Give All Information Completely
Make Required Affidavit
Mail or Deliver Report to:
Conservation Division
State Corporation Commission
212 No. Market
Wichita, Kansas

WELL PLUGGING RECORD

Graham County. Sec. 28 Twp. 10S Rge. 23 ~~XX~~ W (W)

Location as "NE/CNWXSWX" or footage from lines NW NE SE
Lease Owner Sun Oil Company
Lease Name Diebolt LKC Unit Tract 15 Well No. 2
Office Address 800 Security Life Bldg., Denver, Colo.
Character of Well (completed as Oil, Gas or Dry Hole) Oil
Date well completed 5-14 19 55
Application for plugging filed 8-27 19 74
Application for plugging approved 8-29 19 74
Plugging commenced 11-1 19 74
Plugging completed 11-9 19 74
Reason for abandonment of well or producing formation State regulations
require plugging.
If a producing well is abandoned, date of last production September 19 62
Was permission obtained from the Conservation Division or its agents before plugging was commenced? Yes

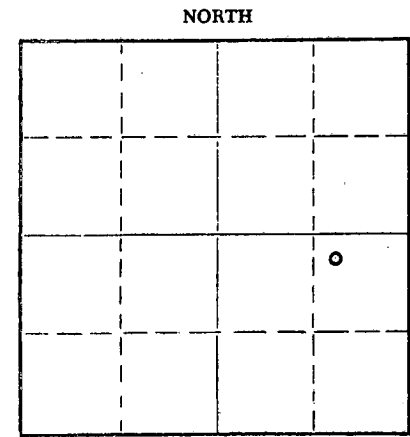

Locate well correctly on above
Section Plat

Name of Conservation Agent who supervised plugging of this well W. L. Nichols
Producing formation Lansing Kansas City Depth to top 3616 Bottom 3842 Total Depth of Well 3900 Feet
Show depth and thickness of all water, oil and gas formations.

OIL, GAS OR WATER RECORDS

CASING RECORD

FORMATION	CONTENT	FROM	TO	SIZE	PUT IN	PULLED OUT
		0	398	9-5/8	398	0
		0	3899	5 1/2	3899	2505

Describe in detail the manner in which the well was plugged, indicating where the mud fluid was placed and the method or methods used in introducing it into the hole. If cement or other plugs were used, state the character of same and depth placed, from feet to feet for each plug set.

Dumped 50 gals. sand and 4 sacks of cement on plug at 3775'. Pulled 2505' of 5 1/2" casing. Displaced hole with 5 sacks hulls, 13 sacks gel, 110 cu. ft. cement, 6 sacks gel. Released plug. Displaced hole with 35 cu. ft. cement, 11 sacks gel, 15 cu. ft. cement to surface.

RECEIVED
STATE CORPORATION COMMISSION
NOV 18 1974
CONSERVATION DIVISION
Wichita, Kansas

(If additional description is necessary, use BACK of this sheet)
Name of Plugging Contractor Charlie Crowe Drilling Co.
Address Box 706, Hays, Kansas

STATE OF COLORADO, COUNTY OF DENVER, ss.
D. A. Coppedge (employee of owner) or (owner or operator) of the above-described well, being first duly sworn on oath, says: That I have knowledge of the facts, statements, and matters herein contained and the log of the above-described well as filed and that the same are true and correct. So help me God.

(Signature) *[Signature]*
800 Security Life Bldg., Denver, CO 80202
(Address)

SUBSCRIBED AND SWORN to before me this 14th day of November, 1974
My commission expires 11-27-75

[Signature]
Notary Public.


WELL LOG BUREAU--KANSAS GEOLOGICAL SOCIETY
508 East Murdock, Wichita, Kansas

Company- MAGNOLIA PETROLEUM CO.
Farm- Steve Nemechek No. 2

SEC. 28 T. 10 R. 23W
NW NE SE

Total Depth. 3900'
Comm. 12-15-54 Comp. 1-14-55
Shot or Treated.
Contractor. Golden Cat Drlg. Co.
Issued. 5-14-55

County Graham
KANSAS

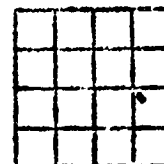

Elevation. 2369 DE

Production State Pot. 98 BO, NW
in 24 hrs. Corr. gr. 35°
allowable 25 BOPD

Figures indicate Bottom of Formations

surface clay-sand	100
sand	175
shale	280
shale-shells	829
shale	1160
sand-shale	1600
red bed-shale	1700
shale-shells	1900
Anhydrite	1930
shale-shells	2415
shale-lime	3500
lime	3850
lime-shale	3900
Total Depth	

RECEIVED
STATE CORPORATION COMMISSION
8-29-1974
AUG 29 1974

CONSERVATION DIVISION
Wichita, Kansas

TOPS:
Heebner 3578
Lansing-Kansas City 3616

DST #1, 3613, 3632, Op. 1 hr.
SI 20 min. Good Blow thruout.
Rec. 60' gas, 660' SW. FP 50-355#,
BHP 1190#.

DST #2, 3790-3807, Op. 1½ hrs.
weak blow 15 min. & died. After
27 min. flushed tool. Repeated
flushing at intervals & lost
packer seat after tool, op. 1 hr.
& 40 min. Rec. 570' drlg. mud.

PERF: 3837-42 w/20 jets. Tested dry 2 hrs.
3817-23 w/24 jets. Tested 2 NOPH.
NW for 10 hrs.

3837-42 w/500 gals. 950#-1100#, 98 BLO.
3837-42 w/1000 gal. MP 1000#, 98 BLO.
Swbd. load & swbd 1 3/4 BOPH
for 16 hrs. NW