

15-065-19011-0000


STATE OF KANSAS
STATE CORPORATION COMMISSION
200 Colorado Derby Bldg.
Wichita, Kansas 67202

Form CP-4
Rev. 12-15-80

WELL PLUGGING RECORD

Give All Information Completely
Make Required Affidavit

COUNTY Graham SEC. 21 TWP. 10S RGE. 23 E/W
Location as in quarters or footage from lines:
SW/4 of SE/4 of SW/4

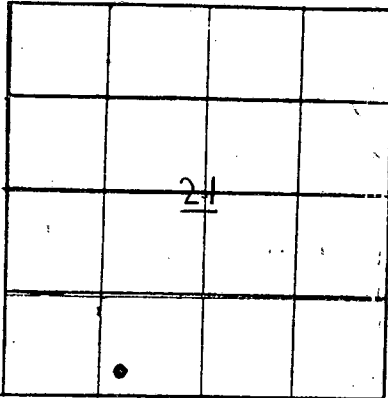

Locate Well
correctly on above
Section Platt.

Lease Owner Sun Exploration & Production Co.
Lease Name Diebolt LKC Unit Well No. 8-4
Office Address P. O. Box 35567-4500 S. Garnett-Tulsa, Okla. 74135
Character of Well (Completed as Oil, Gas or Dry Hole): Water Supply well.
Date Well Completed November 1962
Application for plugging filed February 11, 1983
Plugging commenced March 9, 1983
Plugging completed March 9, 1983
Reason for abandonment of well or producing formation Directed by
State Corporation Commission.

Was permission obtained from the Conservation Division or it's
Agent's before plugging was commenced? yes

Name of Conservation Agent who supervised plugging of this well Dennis Hamel
Producing formation Cheyenne Depth to top 1154 bottom 1244 T.D. 1725'
Show depth and thickness of all water, oil and gas formations.

OIL, GAS OR WATER RECORDS

Casing Record

Formation	Content	From	To	Size	Put in	Pulled Out
Cheyenne	Water	1154	1244	8-5/8"	1696'	None

Describe in detail the manner in which the well was plugged, indicating where the mud fluid was placed and the method or methods used in introducing it into the hold. If cement or other plugs were used, state the character of same and depth placed, from feet to feet for each plug set. Tag top of fill 1526'. Pump in 2 Sx. gel, 130 Sx. Pozmix

w/ 6% gel & 2 Sx hulls, 11 Sx. gel, 50 Sx. Pozmix w/6% gel. Tag TOC 150'. Filled 8-5/8"

w/cement from 150' to surface. Clean up location.

RECEIVED
STATE CORPORATION COMMISSION

MAR 14 1983

CONSERVATION DIVISION
Wichita, Kansas

(If additional description is necessary, use BACK of this sheet)

Name of Plugging Contractor Halliburton

STATE OF Oklahoma COUNTY OF Tulsa, ss.

K. R. Harlow

(employee of owner) or (owner or operator)

of the above-described well, being first duly sworn on oath, says: That I have knowledge of the facts, statements, and matters herein contained and the log of the above-described well as filed, and that the same are true and correct. So help me God.

(Signature) KR Harlow

P. O. Box 35567-Tulsa, Okla. 74135
(Address)

SUBSCRIBED AND SWORN TO before me this 11th day of March, 19 83

Mae Wiley

Notary Public.

My Commission expires: Oct. 2, 1983

