

15-005-21761-0000


STATE OF KANSAS
STATE CORPORATION COMMISSION
200 Colorado Derby Bldg.
Wichita, Kansas 67202

Form CP-4
Rev. 12-15-80

WELL PLUGGING RECORD

Give All Information Completely
Make Required Affidavit

COUNTY Graham SEC. 22 TWP. 10S RGE. 23WE/W
Location as in quarters or footage from lines:
C W/2 E/2 SE/4

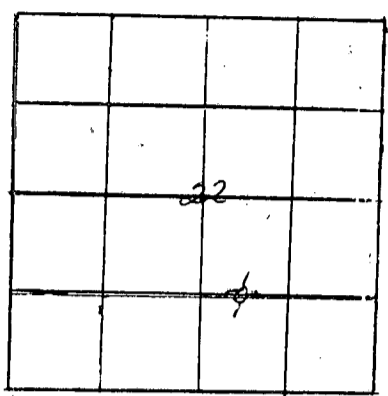

Lease Owner D.G. Hansen Trust
Lease Name CONNES Well No. 1
Office Address Box 187, Logan, KS 67646
Character of Well (Completed as Oil, Gas or Dry Hole): _____
Date Well Completed 2/11/83
Application for plugging filed yes
Plugging commenced 2/11/83
Plugging completed 2/11/83
Reason for abandonment of well or producing formation dry hole

Locate Well
correctly on above
Section Platt.

Was permission obtained from the Conservation Division or it's
Agent's before plugging was commenced? yes

Name of Conservation Agent who supervised plugging of this well Marion Schmidt
Producing formation none Depth to top _____ bottom T.D. 3837

Show depth and thickness of all water, oil and gas formations.

OIL, GAS OR WATER RECORDS Casing Record

Formation	Content	From	To	Size	Put in	Pulled Out
				8 5/8	243'	none

Describe in detail the manner in which the well was plugged, indicating where the mud
fluid was placed and the method or methods used in introducing it into the hold. If cement
or other plugs were used, state the character of same and depth placed, from _____ feet
to _____ feet for each plug set.

1st Plug	1900'	25	sx
2nd Plug	1000'	100	sx
3rd Plug	280'	40	sx
4th Plug	40'	10	sx
Rat Hole		10	sx.
50-50 Poz +6% Gel + 3% CC			

(If additional description is necessary, use BACK of this sheet)

Name of Plugging Contractor Allied Cementing
Box 31, Russell, KS

STATE OF KANSAS COUNTY OF PHILLIPS, ss.
Dane G. Bales, Manager (employee of owner) or (owner or operator) of the
above-described well, being first duly sworn on oath, says: That I have knowledge of the
facts, statements, and matters herein contained and the log of the above-described well as
filed and that the same are true and correct. So help me God.

(Signature) Dane G. Bales
Logan, Kansas 67646
(Address)

SUBSCRIBED AND SWORN TO before me this 21st day of February, 19 83



Betty Jane Bittel
Betty Jane Bittel Notary Public.

My Commission expires: July 17, 1984.

RECEIVED
STATE CORPORATION COMMISSION

APR 08 1983

CONSERVATION DIVISION
Wichita, Kansas