


15-005-02307-0000

STATE OF KANSAS
STATE CORPORATION COMMISSION

WELL PLUGGING RECORD

Give All Information Completely
Make Required Affidavit
Mail or Deliver Report to:
Conservation Division
State Corporation Commission
800 Bitting Building
Wichita, Kansas

Graham County, Sec. 27 Twp. 10S Rge. (E) 23 (W)
Location as "NE/CNWxSWx" or footage from lines NW 1/4 NW 1/4 SW 1/4
Lease ~~owner~~ Operator: Birmingham-Bartlett Drilling Co.
Lease Name Schultz Well No. 1A
Office Address 300 Kaufman Building, Wichita 2, Kansas
Character of Well (completed as Oil, Gas or Dry Hole) Dry Hole
Date well completed May 11 19 55
Application for plugging filed (Verbal) May 11 19 55
Application for plugging approved (Verbal) May 11 19 55
Plugging commenced May 11 19 55
Plugging completed May 11 19 55
Reason for abandonment of well or producing formation Dry Hole

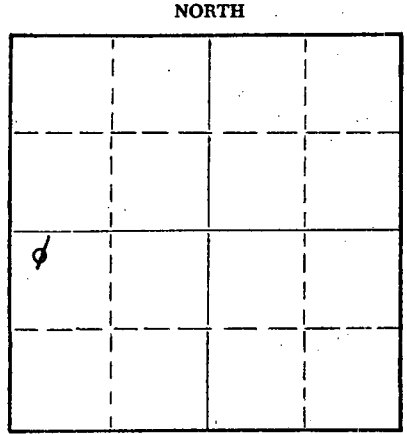

Locate well correctly on above
Section Plat

If a producing well is abandoned, date of last production _____ 19____
Was permission obtained from the Conservation Division or its agents before plugging was commenced? Yes

Name of Conservation Agent who supervised plugging of this well Eldon Petty
Producing formation _____ Depth to top _____ Bottom _____ Total Depth of Well 3870 Feet
Show depth and thickness of all water, oil and gas formations.

OIL, GAS OR WATER RECORDS

CASING RECORD

FORMATION	CONTENT	FROM	TO	SIZE	PUT IN	PULLED OUT
		0'	244'	8-5/8"	244'	None

Describe in detail the manner in which the well was plugged, indicating where the mud fluid was placed and the method or methods used in introducing it into the hole. If cement or other plugs were used, state the character of same and depth placed, from _____ feet to _____ feet for each plug set.

Filled hole to 230' with heavy mud. Set plug with 1/2 sack hulls and mix and pour 15 sacks cement. Fill to 40' with mud and set plug and hulls. Mixed and poured 10 sacks cement. Filled with mud to surface.

RECEIVED
STATE CORPORATION COMMISSION
MAY 14 1955 05-14-55
CONSERVATION DIVISION
Wichita, Kansas

(If additional description is necessary, use BACK of this sheet)
Name of Plugging Contractor Birmingham-Bartlett Drilling Co.
Address 300 Kaufman Building, Wichita 2, Kansas

STATE OF KANSAS COUNTY OF SEDGWICK
Richard Hindery, partner of Birmingham-Bartlett Drilling Co., ss. contractor and operator
(employee of owner) or (owner or operator) of the above-described well, being first duly sworn on oath, says: That I have knowledge of the facts, statements, and matters herein contained and the log of the above-described well as filed and that the same are true and correct.—So help me God.—BIRMINGHAM-BARTLETT DRILLING CO.

(Signature) By Richard Hindery, Partner
300 Kaufman Building, Wichita 2, Kansas
(Address)

SUBSCRIBED AND SWORN TO before me this 13th day of May, 19 55.

My commission expires November 29, 1958.

Vincent J. Ginger
Notary Public.



PLUGGING
FILE SEC 27 T 10 R 23 W
BOOK PAGE 18 LINE 39

SCHULTZ #1A WELL

LOCATION: NW $\frac{1}{4}$ NW $\frac{1}{4}$ SW $\frac{1}{4}$ Sec. 27-10S-23W
Graham County, Kansas

SPUDDED: 5-2-55

COMPLETED: 5-11-55

OPERATOR and CONTRACTOR: Birmingham-Bartlett Drilling Co.
300 Kaufman Building
Wichita 2, Kansas

SURFACE CASING: 8-5/8" casing cemented at 244'
with 185 sacks cement and 3 c.c.

OIL STRING: None set. Dry and Abandoned.

LOG

(Figures indicate bottom of formation)

0 -	244	Sand & Shale
	1275	Sand, Shale & Shells
	1885	Shale & Shells
	1925	Anhydrite
	2360	Shale & Shells
	3660	Lime & Shale
	3870	Lime
	3870	RTD - D & A

The undersigned, Richard Hindery, one of the partners of Birmingham-Bartlett Drilling Co., hereby certifies that the above is a true and correct log of the formations encountered in drilling the Schultz #1A Well as shown in the daily drilling reports.

BIRMINGHAM-BARTLETT DRILLING CO.


BY Richard Hindery

Subscribed and sworn to before me this 13th day of May, 1955.

RECEIVED
STATE CORPORATION COMMISSION
MAY 14 1955
CONSERVATION DIVISION
Wichita, Kansas

Vivian F. Ginger
Notary Public

My commission expires November 29, 1958.

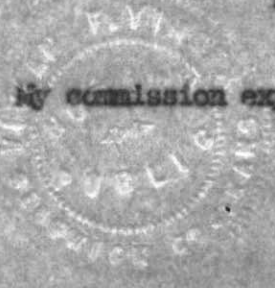

PLUGGING
WELL SEC 27 T 10 S 23 W
BOOK PAGE 118 LINE 39