


STATE OF KANSAS  
STATE CORPORATION COMMISSION  
CONSERVATION DIVISION  
P. O. BOX 17027  
WICHITA, KANSAS 67217

FORM CP-4

WELL PLUGGING RECORD

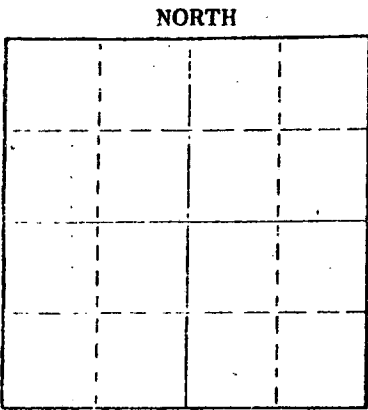

Locate well correctly on above Section Plat

Graham County. Sec. 27 Twp. 10 Rge. 23 (E) W (W)  
Location as "NE/CNW&SW" or footage from lines C-N<sub>2</sub> - SW - NE  
Lease Owner Dreiling Oil, Inc.  
Lease Name Klenk Well No. 3  
Office Address Rt. #2, Victoria, KS 67671  
Character of Well (completed as Oil, Gas or Dry Hole) Dry Hole  
Date well completed 1-7 1975  
Application for plugging filed 1-7 1975  
Application for plugging approved 1-7 1975  
Plugging commenced 1-7 1975  
Plugging completed 1-7 1975  
Reason for abandonment of well or producing formation Dry Hole

If a producing well is abandoned, date of last production 19  
Was permission obtained from the Conservation Division or its agents before plugging was commenced? yes

Name of Conservation Agent who supervised plugging of this well Dale Balthazor, Phillipsburg, KS  
Producing formation \_\_\_\_\_ Depth to top \_\_\_\_\_ Bottom \_\_\_\_\_ Total Depth of Well 3,826 Feet  
Show depth and thickness of all water, oil and gas formations.

OIL, GAS OR WATER RECORDS

CASING RECORD

FORMATION	CONTENT	FROM	TO	SIZE	PUT IN	PULLED OUT
Surface Pipe				8 5/8"	112'	

Describe in detail the manner in which the well was plugged, indicating where the mud fluid was placed and the method or methods used in introducing it into the hole. If cement or other plugs were used, state the character of same and depth placed, from \_\_\_\_\_ feet to \_\_\_\_\_ feet for each plug set.

1st plug was set @ 900' w/70 cu. ft. cement  
2nd plug was set @ 120' w/20 cu. ft. cement  
3rd plug was set @ 40' w/10 cu. ft. cement

RECEIVED  
STATE CORPORATION COMMISSION

JAN 13 1975  
01-13-75

CONSERVATION DIVISION

(If additional description is necessary, use BACK of this sheet)  
Name of Plugging Contractor Dreiling Oil, Inc. (Wichita, Kansas)  
Address Rt. #2, Victoria, KS 67671

STATE OF KANSAS COUNTY OF ELLIS  
I, Joseph A. Hess, Sec. Treas. of Drlg. Contr. (owner or operator) of the above-described well, being first duly sworn on oath, says: That I have knowledge of the facts, statements, and matters herein contained and the log of the above-described well as filed and that the same are true and correct. So help me God.

(Signature) Joseph A. Hess

JOSEPH A. HESS, Hays, KS 67601  
(Address)

Sworn to before me this 10 day of January, 19 75

September 13, 1976

Cecilia Basgall  
Cecilia Basgall

Notary Public.



