


WELL PLUGGING RECORD

Give All Information Completely
Make Required Affidavit
Mail or Deliver Report to:
Conservation Division
State Corporation Commission
800 Bitting Building
Wichita, Kansas

Graham County. Sec. 27 Twp. 10S Rge. 23 (W)

Location as "NE/CNW $\frac{1}{4}$ /SW $\frac{1}{4}$ " or footage from lines SE $\frac{1}{4}$ SE $\frac{1}{4}$ SW $\frac{1}{4}$
Lease Owner HEATHMAN & CO.
Lease Name SCHULTZ Well No. 1
Office Address 509 Orpheum Building, Wichita 2, Kansas
Character of Well (completed as Oil, Gas or Dry Hole) Dry hole
Date well completed 12-24 1951
Application for plugging filed 12-24 1951
Application for plugging approved 12-24 1951
Plugging commenced 12-24 1951
Plugging completed 12-24 1951
Reason for abandonment of well or producing formation Dry hole

NORTH

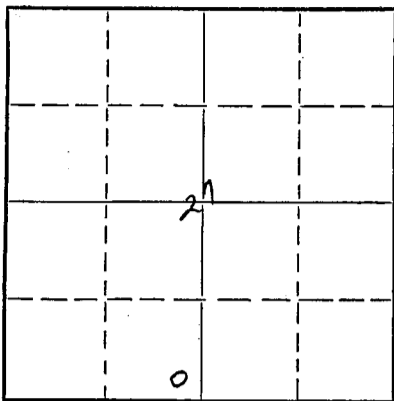

Locate well correctly on above Section Plat

If a producing well is abandoned, date of last production _____ 19____
Was permission obtained from the Conservation Division or its agents before plugging was commenced? yes

Name of Conservation Agent who supervised plugging of this well Eldon Petty, Box 326, Hays, Kansas
Producing formation _____ Depth to top _____ Bottom _____ Total Depth of Well 4113 Feet
Show depth and thickness of all water, oil and gas formations.

OIL, GAS OR WATER RECORDS

CASING RECORD

Formation	Content	From	To	Size	Put In	Pulled Out
None					8-5/8" (5 jts.) cemented at 152.79'	152.79'
					sacks cement and 1 sack C.C.	
					None pulled	

Describe in detail the manner in which the well was plugged, indicating where the mud fluid was placed and the method or methods used in introducing it into the hole. If cement or other plugs were used, state the character of same and depth placed, from _____ feet to _____ feet for each plug set.

Filled hole with heavy mud; set plug at 155'; cemented with 50 sacks to bottom of cellar; cut pipe off 3' below level of ground.

STATE CORPORATION COMMISSION
DIVISION
JAN - 8 1952
01-08-52
WICHITA, KANSAS


(If additional description is necessary, use BACK of this sheet)

Correspondence regarding this well should be addressed to Globe Oilwell Cementing Co.
Address P. O. Box 628, Great Bend, Kansas

STATE OF KANSAS, COUNTY OF SEDGWICK
H. D. Shreve (Employee/Owner) or (owner & operator) of the above-described well,
being first duly sworn on oath, says: That I have knowledge of the facts, statements, and matters herein contained and the log of the above-described well as filed and that the same are true and correct. So help me God.

(Signature) [Signature]
509 Orpheum Building, Wichita, Kansas
(Address)

My commission expires before me this 7th day of January, 1952
D. Marjorie Mott
Notary Public.

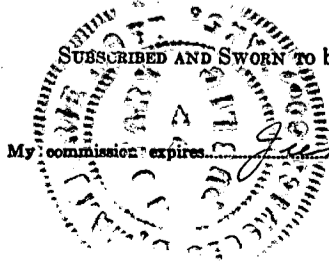

PLUGGING
FILE SEC 27 T 10 R 23W
BOOK PAGE 134 LINE 39

SCHULTZ WELL NO. 1

Location:	SE/4 SE/4 SW/4 Sec. 27-10S-23W Graham County, Kansas	Date Spudded:	12-10-51
Operator:	Heathman & Co.	Rotary Completed:	12-24-51
Contractor:	Heathman & Co.	Elevation:	2304' Gr; 2307' DF 2309' KB
Surface Casings:	5 jts. 8-5/8" (152.79') set @ 158' w/110 sacks cement and 1 sack C.C.	Rotary Total Depth:	4113'
Oil String:	None - D & A		

GEOLOGICAL TOPS (KB)

Heobner	3544 (-1235)
Lansing-Kansas City	3578 (-1269)
Base of Kansas City	3806 (-1497)
Marmaton Chert	3915 (-1606)
Conglomerate	4006 (-1697)
Simpson	4059 (-1750)
Arbuckle	4084 (-1775)
Rotary Total Depth	4113 (-1804)

L O G

(Figures indicate bottom of formation)

Shale, shells and sand	0 to 489
Shale and shells	852
Shale and sand	1350
Sand and shale	1440
Sand	1530
Shale and shells	1820
Anhydrite	1868
Shale	1897
Shale and shells	2275
Shale	2285
Shale and shells	2419
Shale and lime	2444
Lime and shale	2678
Shale and lime	3343
Lime	3425
Lime and shale	3629
Shale and lime	3701
Lime and shale	3802
Shale and lime	3853
Lime and shale	3948
Shale and lime	3957
Lime and shale	4017
Lime, chert and shale	4052
Chert conglomerate	4066
Chert, lime and shale	4096
Lime and shale	4113
Total Depth	4113

STATE OF KANSAS
JAN - 5 1952
COMMISSIONER OF GEOLOGY
Topeka, Kansas

The undersigned, H. D. Shreve, hereby certifies that the above log is a true and correct log of the formations encountered in drilling the above noted well as reflected by the Daily Drilling Reports.

HEATHMAN & CO.

By H. D. Shreve
Partner



Subscribed and sworn to before me this 7th day of January 1952
D. Maryone Mott
Notary Public

PLUGGING
FILE SEC 27 T 10 R 23W
BOOK PAGE 134 LINE 39

My commission expires June, 28, 1952