


15-065-02067-0000

WELL PLUGGING RECORD

Give All Information Completely
Make Required Affidavit
Mail or Deliver Report to:
Conservation Division
State Corporation Commission
212 North Market, Insurance Bldg.
Wichita, Kansas

Graham County. Sec. 1 Twp. 10 Rge. 24 (E) (W)
Location as "NE/CNW/SW" or footage from lines Center of the East Line SE 1/4
Lease Owner D. G. Hansen
Lease Name George Gano Well No. 3
Office Address Logan, Kansas
Character of Well (completed as Oil, Gas or Dry Hole) Dry Hole
Date well completed November 13 1961
Application for plugging filed November 13 1961
Application for plugging approved November 13 1961
Plugging commenced November 13 1961
Plugging completed November 13 1961
Reason for abandonment of well or producing formation Too low structurally

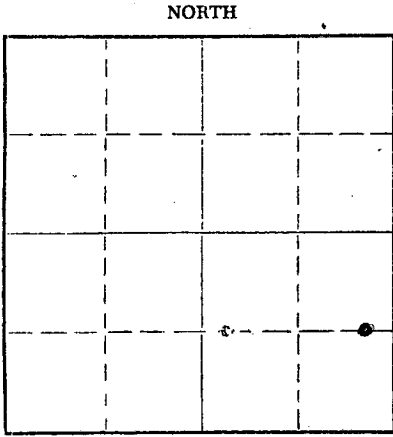

Locate well correctly on above Section Plat

If a producing well is abandoned, date of last production _____ 19____
Was permission obtained from the Conservation Division or its agents before plugging was commenced? Yes

Name of Conservation Agent who supervised plugging of this well Eldon Petty, Hays, Kansas
Producing formation _____ Depth to top _____ Bottom _____ Total Depth of Well 4036 Feet
Show depth and thickness of all water, oil and gas formations.

OIL, GAS OR WATER RECORDS

CASING RECORD

FORMATION	CONTENT	FROM	TO	SIZE	PUT IN	PULLED OUT
				8-5/8"	200.40'	None

Describe in detail the manner in which the well was plugged, indicating where the mud fluid was placed and the method or methods used in introducing it into the hole. If cement or other plugs were used, state the character of same and depth placed, from _____ feet to _____ feet for each plug set.

Filled hole with heavy mud to 460'.
Set plug. Put in 20 sacks cement.
Filled to 180'. Set plug. Put in
20 sacks cement. Filled with heavy
mud up to 40'. Set plug. Filled
to top with 1 sack hulls and 10
sacks cement.

STATE CORPORATION COMMISSION
12-07-61
CONSERVATION DIVISION
Wichita, Kansas


RECEIVED
NOV 13 1961
D. G. HANSEN

(If additional description is necessary, use BACK of this sheet)
Name of Plugging Contractor C-G Drilling Co.
Address 107 Rule Building, Wichita 2, Kansas

STATE OF KANSAS, COUNTY OF SEDGWICK ss.
G. F. Galloway (employee of owner) or (owner or operator) of the above-described well, being first duly sworn on oath, says: That I have knowledge of the facts, statements, and matters herein contained and the log of the above-described well as filed and that the same are true and correct. So help me God.

(Signature) G. F. Galloway
107 Rule Building
(Address)

SUBSCRIBED AND SWORN TO before me this 13th day of November, 1961

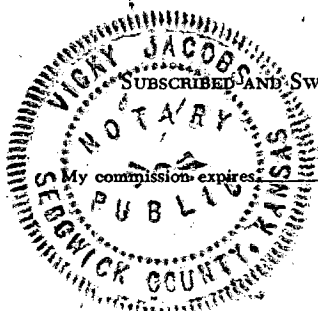

Vicky Jacobs
Notary Public.

15-065-02067-0000

WELL LOG

OPERATOR D. G. Hansen SEC. 1-10-24
 WELL NAME George Gano #3 LOC. C East Line SE 1/4
 TOTAL DEPTH 4036' COUNTY Graham
 COMM. November 4, 1961 COMP. November 13, 1961 STATE Kansas
 RIG NO. 1 ELEVATION 2464' KB.
 CASING: Ran 200.40' (10 jts.) 8-5/8" OD Surface Casing. PRODUCTION: D & A

All measurements taken from the top of rotary bushing.

FROM	TO	FORMATION	DEVIATION FROM VERTICAL	REMARKS:
0	315	Shale & Sand		
315	1345	Sand & Shale		
1345	1670	Shale		
1670	1800	Sand		
1800	1955	Shale		
1955	2074	Red Bed		
2074	2116	Anhydrite		
2116	2315	Shell & Shale		
2315	2735	Shale & Lime	00 - 2500	
2735	3670	Lime & Shale	00 - 2750	
3670	3745	Shale & Lime	00 - 3000	
3745	3825	Lime & Shale	00 - 3250	
3825	3940	Lime	00 - 3500	DST 3864-3877'
3940	3966	Lime & Shale	00 - 3750	DST 3951-3966'
3966	3986	Lime		DST 3964-3986'
3986	4006	Lime & Shale		DST 3984-4006'
4006	4036	Lime		

RECEIVED
 STATE CORPORATION COMMISSION
 DEC 7 1961
 CONSERVATION DIVISION
 Wichita, Kansas

RECEIVED
 NOV 13 1961
 D. G. HANSEN
 Time.....

STATE OF KANSAS)
) SS.
 COUNTY OF SEDGWICK)

The undersigned hereby certifies that to the best of his knowledge and belief, the above facts are true and correct.

C-G DRILLING CO.
 By G. F. Galloway
 G. F. Galloway
 THIS 17th day of November, 1961.
Vicky Jacobs
 Vicky Jacobs - Notary Public

