


STATE OF KANSAS  
STATE CORPORATION COMMISSION

Give All Information Completely  
Make Required Affidavit  
Mail or Deliver Report to:  
Conservation Division  
State Corporation Commission  
211 No. Broadway  
Wichita, Kansas

WELL PLUGGING RECORD

Graham County. Sec. 20 Twp. 10S Rge. 23W (E) (W)

Location as "NE/CNW/SW" or footage from lines NE SE NW  
Lease Owner Imperial Oil of Kansas, Inc.  
Lease Name Walker "B" Well No. 1  
Office Address Wichita, Kansas  
Character of Well (completed as Oil, Gas or Dry Hole) Dry Hole  
Date well completed September 8, 1956  
Application for plugging filed September 8, 1956  
Application for plugging approved September 8, 1956  
Plugging commenced September 8, 1956  
Plugging completed September 8, 1956  
Reason for abandonment of well or producing formation No oil in commercial quantities found.

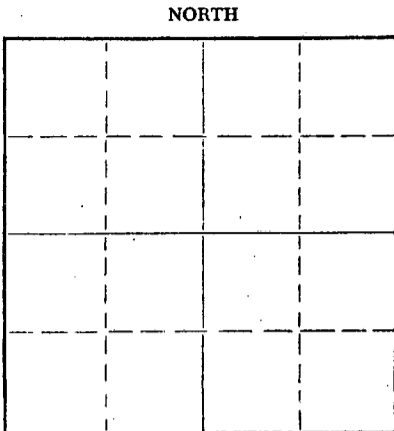

Locate well correctly on above Section Plat

If a producing well is abandoned, date of last production \_\_\_\_\_ 19\_\_\_\_  
Was permission obtained from the Conservation Division or its agents before plugging was commenced? Yes

Name of Conservation Agent who supervised plugging of this well Eldon Petty, Hays, Kansas  
Producing formation \_\_\_\_\_ Depth to top \_\_\_\_\_ Bottom \_\_\_\_\_ Total Depth of Well 3960 Feet  
Show depth and thickness of all water, oil and gas formations.

OIL, GAS OR WATER RECORDS

CASING RECORD

FORMATION	CONTENT	FROM	TO	SIZE	PUT IN	PULLED OUT
				8-5/8"	9-8-56	

Describe in detail the manner in which the well was plugged, indicating where the mud fluid was placed and the method or methods used in introducing it into the hole. If cement or other plugs were used, state the character of same and depth placed, from \_\_\_\_\_ feet to \_\_\_\_\_ feet for each plug set.

Set No. 1 plug at 180 feet with 15 sacks cement. Set top plug at 35 feet with 10 sacks cement to surface.

(If additional description is necessary, use BACK of this sheet)

Name of Plugging Contractor Imperial Oil of Kansas, Inc.  
Address 903 Union National Bank Building, Wichita, Kansas

STATE OF KANSAS, COUNTY OF SEDGWICK, ss.  
Raymond L. Bacon (employee of owner) or (owner or operator) of the above-described well, being first duly sworn on oath, says: That I have knowledge of the facts, statements, and matters herein contained and the log of the above-described well as filed and that the same are true and correct. So help me God. IMPERIAL OIL OF KANSAS, INC.

(Signature) By: Raymond L. Bacon V-P  
903 Union National Bank, Wichita, Kansas (Address)



Francis E. Barham Notary Public.  
9-27-1956  
SEP 27 1956

PLUGGING  
FILE SEC 20 T 10 R 23W  
BOOK PAGE 97 LINE 37

CONSERVATION DIVISION  
Wichita, Kansas

DRILLER'S LOG

Imperial Oil of Kansas, Inc.  
 903 Union National Bank Building  
 Wichita 2, Kansas

Walker "B" No. 1  
 NE SE NW Sec. 2-10S-23W  
 Graham County, Kansas

Total Depth: 3950'

Elevation: 2410' R.B.  
 Production: D & A

Commenced: 8-30-56 Completed 9-8-56

Contractor: Imperial Oil of Kansas, Inc.  
 Wichita, Kansas

Casing Record: Set 8-5/8" Surface Pipe at 195' with 150 sacks cement.

Figures indicate bottom of formations:

Sand and Clay	120'		
Shale and Shells	990'		
Sand and Shale	1245'		<u>TOPS</u>
Sand	1304'	Anhydrite	1975' (435)
Shale and Sand	1700'	Heebner	3681' (-1271)
Red Bed and Shale	1975'	Toronto	3700' (-1290)
Anhydrite	2005'	Lansing	3716' (-1306)
Shale and Red Bed	2465'	Total Depth	3950' (-1540)
Shale and Lime	3620'		
Lime	3950'		
Total Depth	3950'		

We hereby certify this to be a correct and accurate log of the above described well as shown on the daily drilling reports.

**PLUGGING**  
 FILE SEC. 20 T. 10 R. 23W  
 BOOK PAGE 91 LINE 37

IMPERIAL OIL OF KANSAS, INC.

By: Ray L. Duen  
 Vice-President

Subscribed and sworn to before me this 21st day of September, 1956.

My Commission Expires: **RECEIVED**  
 STATE CORPORATION COMMISSION  
 9-27-1956  
 SEP 27 1956

April 18, 1959

Francis C. Barkson  
 Notary Public

CONSERVATION DIVISION  
 Wichita, Kansas