

STATE OF KANSAS
STATE CORPORATION COMMISSION


WELL PLUGGING RECORD

Give All Information Completely
Make Required Affidavit
Mail or Deliver Report to:
Conservation Division
State Corporation Commission
800 Biting Building
Wichita, Kansas

Graham County. Sec. 20 Twp. 10S Rge. (E) 23 (W)

Location as "NE/CNWxSWx" or footage from lines SW/4 SW/4 NW/4
Lease Owner Walters Drilling Co., et al.
Lease Name Walker Well No. 1
Office Address 510 Orpheum Building, Wichita 2, Kansas
Character of Well (completed as Oil, Gas or Dry Hole) Dry Hole
Date well completed September 19, 19 55
Application for plugging filed (verbal) September 19, 19 55
Application for plugging approved (verbal) September 19, 19 55
Plugging commenced September 20, 19 55
Plugging completed September 20, 19 55
Reason for abandonment of well or producing formation Dry Hole

NORTH

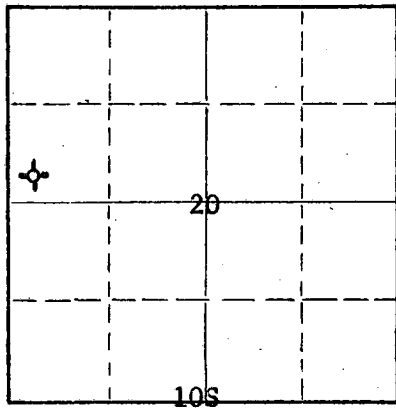

Locate well correctly on above Section Plat

If a producing well is abandoned, date of last production 19
Was permission obtained from the Conservation Division or its agents before plugging was commenced? Yes

Name of Conservation Agent who supervised plugging of this well Eldon Petty, Hays, Kansas
Producing formation None Depth to top Bottom Total Depth of Well 3980 Feet
Show depth and thickness of all water, oil and gas formations.

OIL, GAS OR WATER RECORDS

CASING RECORD

FORMATION	CONTENT	FROM	TO	SIZE	PUT IN	PULLED OUT
None	None	0	187'	8 5/8"	187'	None

Describe in detail the manner in which the well was plugged, indicating where the mud fluid was placed and the method or methods used in introducing it into the hole. If cement or other plugs were used, state the character of same and depth placed, from feet to feet for each plug set.

Set bottom plug at 180' with heavy mud and 15 sacks cement and 1/2 sack Hulls.


Set top plug at 40' with heavy mud and 10 sacks cement and 1/2 sack Hulls.

(If additional description is necessary, use BACK of this sheet)
Name of Plugging Contractor Walters Drilling Co.
Address 510 Orpheum Building, Wichita 2, Kansas

STATE OF Kansas COUNTY OF Sedgwick, ss.
Russell I. Baker (employee of owner) of the above-described well, being first duly sworn on oath, says: That I have knowledge of the facts, statements, and matters herein contained and the log of the above described well as filed and that the same are true and correct. So help me God.

(Signature) Russell I. Baker
510 Orpheum Building, Wichita 2, Kansas
(Address)

SUBSCRIBED AND SWORN to before me this 21st day of September, 19 55
My commission expires March 10, 1956

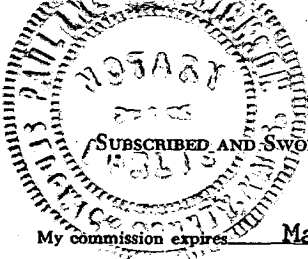

Pauline Hendrickson
STATE CORPORATION COMMISSION
Wichita, Kansas
Notary Public.

PLUGGING
FILE SEC 20 T 10 R 23 W
BOOK PAGE 2 LINE 8

WALKER NO. 1

Location: SW SW NW Sec. 20-10S-23W
Graham County, Kansas

Date Spudded: 9-3-55

Operator: Walters Drilling Co.

Rotary Completion: 9-19-55

Contractor: Walters Drilling Co.

Elevation: 2398 Gr
2401 DF
2403 KB

Surface Casing: 8 5/8" set at 187' with
100 sacks cement and
1 Cal. Chloride

Oil String: None. D & A

L O G

(Figures indicate bottom of formation)

Surface	0 to 187
Shale and Shells	1545
Sand	1736
Shale	1745
Shale and Shells	1983
Anhydrite	2031
Shale and Shells	2515
Lime and Shale	3777
Lime	3940
Lime and Shale	3980
Total Depth	3980

The undersigned, Russell I. Baker, hereby certifies that the above log is a true and correct log of the formations encountered in drilling the above noted well as reflected by the Daily Drilling Reports.

WALTERS DRILLING CO.

By

Russell I. Baker

Russell I. Baker



Subscribed and sworn to before me
this 21st day of September, 1955.

Pauline Hendrickson

Pauline Hendrickson, Notary Public

My commission expires:
March 10, 1956

