

CARD MUST BE TYPED

State of Kansas
NOTICE OF INTENTION TO DRILL
(see rules on reverse side)

CARD MUST BE SIGNED

Starting Date: January 18, 1985
month day year

8:25

API Number 15- 065-22,136-0000

OPERATOR: License # 5181
Name DONALD C. SLAWSON
Address 200 Douglas Bldg.
City/State/Zip Wichita, Kansas 67202
Contact Person Bill Horigan
Phone (316)263-3201

NE NE NE Sec 21 Twp 10 S, Rge 23W East
(location) West

4950 Ft North from Southeast Corner of Section
330 Ft West from Southeast Corner of Section
(Note: Locate well on Section Plat on reverse side)

CONTRACTOR: License # 5657
Name Slawson Drilling Co., Inc.
City/State Wichita, KS 67202

Nearest lease or unit boundary line 330' feet.
County Graham
Lease Name Nemechek 'B' Well# 1

Domestic well within 330 feet: yes no
Municipal well within one mile: yes no

Well Drilled For: Well Class: Type Equipment:
 Oil Swd Infield Mud Rotary
 Gas Inj Pool Ext. Air Rotary
 OWWO Expl Wildcat Cable

Depth to Bottom of fresh water 90 feet
Lowest usable water formation Dakota
Depth to Bottom of usable water 1000-1150 feet

If OWWO: old well info as follows:
Operator
Well Name
Comp Date Old Total Depth
Projected Total Depth 3900 feet
Projected Formation at TD BKC
Expected Producing Formations LKC

Surface pipe by Alternate: 1 2
Surface pipe to be set 200 feet
Conductor pipe if any required None feet
Ground surface elevation 2345 feet MSL
This Authorization Expires 7-18-85
Approved By 1-18-85

I certify that we will comply with K.S.A. 55-101, et seq., plus eventually plugging hole to K.C.C. specifications.

Date 1/18/85 Signature of Operator or Agent

Eldon S. West III
Eldon S. West III

Title Div. Mgr./Geol.

MHC/W/DHE 1-18-85


Must be filed with the K.C.C. five (5) days prior to commencing well
 This card void if drilling not started within six (6) months of date received by K.C.C.

Wichita, Kansas

CONSERVATION DIVISION

58-81-10 JAN 18 1985

A Regular Section of Land
 RECEIVED
 STATE CORPORATION COMMISSION

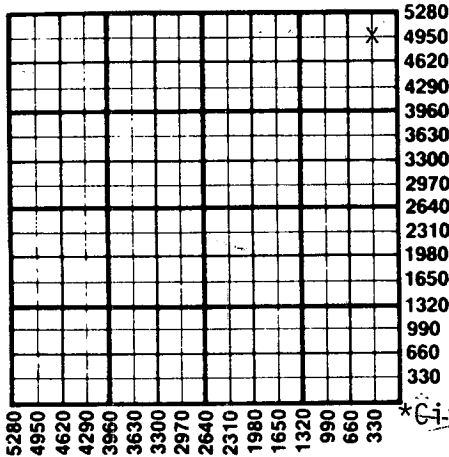

Important procedures to follow :

1. Notify District office before setting surface casing.
2. Set surface casing by circulating cement to the top.
3. File completion forms ACO-1 with K.C.C. within 90 days of well completion, following instructions on ACO-1, side 1, and including copies of wireline logs.
4. Notify District office 48 hours prior to old well workover or re-entry.
5. Prior to plugging, prepare a plugging plan, then obtain agreement from the appropriate district office for an approved plugging plan.
6. Submit plugging report (CP-4) to K.C.C. after plugging is completed.
7. Obtain an approved injection docket number before disposing of salt water.
8. Notify K.C.C. within 10 days when injection commences or terminates.
- *9. If an alternate 2 completion, cement in the production pipe from below any usable water to surface within 120 days of spud date.

~~*Circulate alternative cementing material per 82-3-106(b)4.~~

State Corporation Commission of Kansas

Conservation Division
 200 Colorado Derby Building
 Wichita, Kansas 67202
 (316) 263-3238